



Date: January 11, 2016

Bid Date: January 18, 2016

Architect: Milnet Architectural Services
608 S. 12th St.
McAllen, TX 78501



NOTICE TO ALL BIDDERS

This Addendum forms a part of the Contract Document and modifies the original Drawings issued for bid, to the extent noted herein.

Careful note of this Addendum shall be taken by all parties of interest so that proper allowance is made in all computations, estimates and contracts and so that all trades affected are fully advised in the performance of work that will be required by them. Acknowledge receipt of this addendum by inserting its number and date of issue in the place provided for same in the proposal.

Items revised on the Drawings are designated by a cloud line and triangle surrounding the corresponding revision number.


This Addendum supersedes all previous Drawings, Specifications and instructions pertaining to these items. It is imperative that this addendum be inserted INTO set of specifications.

- 1.01 Refer to detail 1/A8.0-SK1 for proposed building plaque layout.
- 1.02 For Wire shelf at Laundry room 118, please use ClosetMaid white with adjustable mount wire shelving or equal
- 1.03 Approved manufacturer for FOLDING PARTITIONS 10651 Part 2 Products – 2.02. B. Signature 8600 Individual Panels from MODERCO. Contact: Lance Finley, Rob Pelletier Construction. 12402 Eastex Freeway, Houston, TX. 77039. P: 512-962-9522.
- 1.04 Update spec section 10350.1.5.A to read: The General Contractor shall furnish and install two tapered aluminum flagpoles and all fittings, top ornament, lighting, ground spike with plate, foundation, grounding facilities and all appurtenant work, all in accordance with the requirements of the Contract Documents.
- 1.05 Update spec section 10350.2.3.C to read: Flags: Owner provided.
- 1.06 APPEND spec section 08411 ALUMINUM ENTRANCES AND STOREFRONTS
- 1.07 APPEND spec section 08730 THRESHOLDS, WEATHERSTRIPPING AND SEALS
- 1.08 CLARIFICATION: Provide and install fourteen (14) wall mounted Red Ready Racks 24” Wide.
- 1.09 CLARIFICATION: Materials listed in sheet A4.0 pertain to ceiling finishes only
- 1.10 CLARIFICATION: Numbers listed in TOILET ACCESSORIES LEGEND pertain to corresponding TOILET ACCESSORIES NOTES.



- 1.11 CLARIFICATION: On bid form mark OTHER and specify GENERAL CONTRACTOR if pricing not from Texas recognized and approved cooperatives such as: Buyboard, TXMAS, etc.
- 1.12 CLARIFICATION: General Contractor is responsible to obtain building permit, however the City of Edinburg waives permit fees. General Contractor is responsible to pay for new water meter fees.
- 1.13 CLARIFICATION: Door type G is 12'-0"W x 14'-0"H
- 1.14 CORRECTION: Alternates definition:
 - 1.14.1 Alternate #1: Provide mezzanine at garage area.
 - 1.14.2 Alternate #2: Provide truck wash station at driveway along north property line (Base Bid is heavy duty HMAC pavement).
 - 1.14.3 Alternate #3: Build community rooms, kitchen & restrooms (Rm #101, 102, 104, 105, 106 & 107). Provide parking lot on the south, total of 37 parking spaces.
 - 1.14.4 Alternate #4: Build third bay at garage (Rm #124). Base bid the garage dimensions are: 44'-8"W x 120'-0"D, with alternate #4 approved, it would be: 60'-8"W x 120'-0"D. Also part of alternate #4 is to make truck driveway 44'-0" wide.
- 1.15 CORRECTION: Update AIA Document A101-2007. Section 3.3. to read: The Contractor shall achieve Substantial Completion of the entire Work not later than Three Hundred (300) days from the date of commencement, or as follows:
- 1.16 CORRECTION: Update detail 2/A3.0 with the attached 1/A3.0-SK-1
- 1.17 CORRECTION: Replace sheets A4.0, A5.0, A7.1 with the attached corresponding sheets
- 1.18 CORRECTION: Update Hinojosa Engineering address and phone number to read: 108 W. 18TH ST., MISSION, TX. 78572. Ph. (956) 581-0143.
- 1.19 CORRECTION: Replace with the attached 09910 Painting & Finishing spec section the 09900 spec section.
- 1.20 Refer attached MEP, CIVIL & STR addenda

END OF ADDENDUM

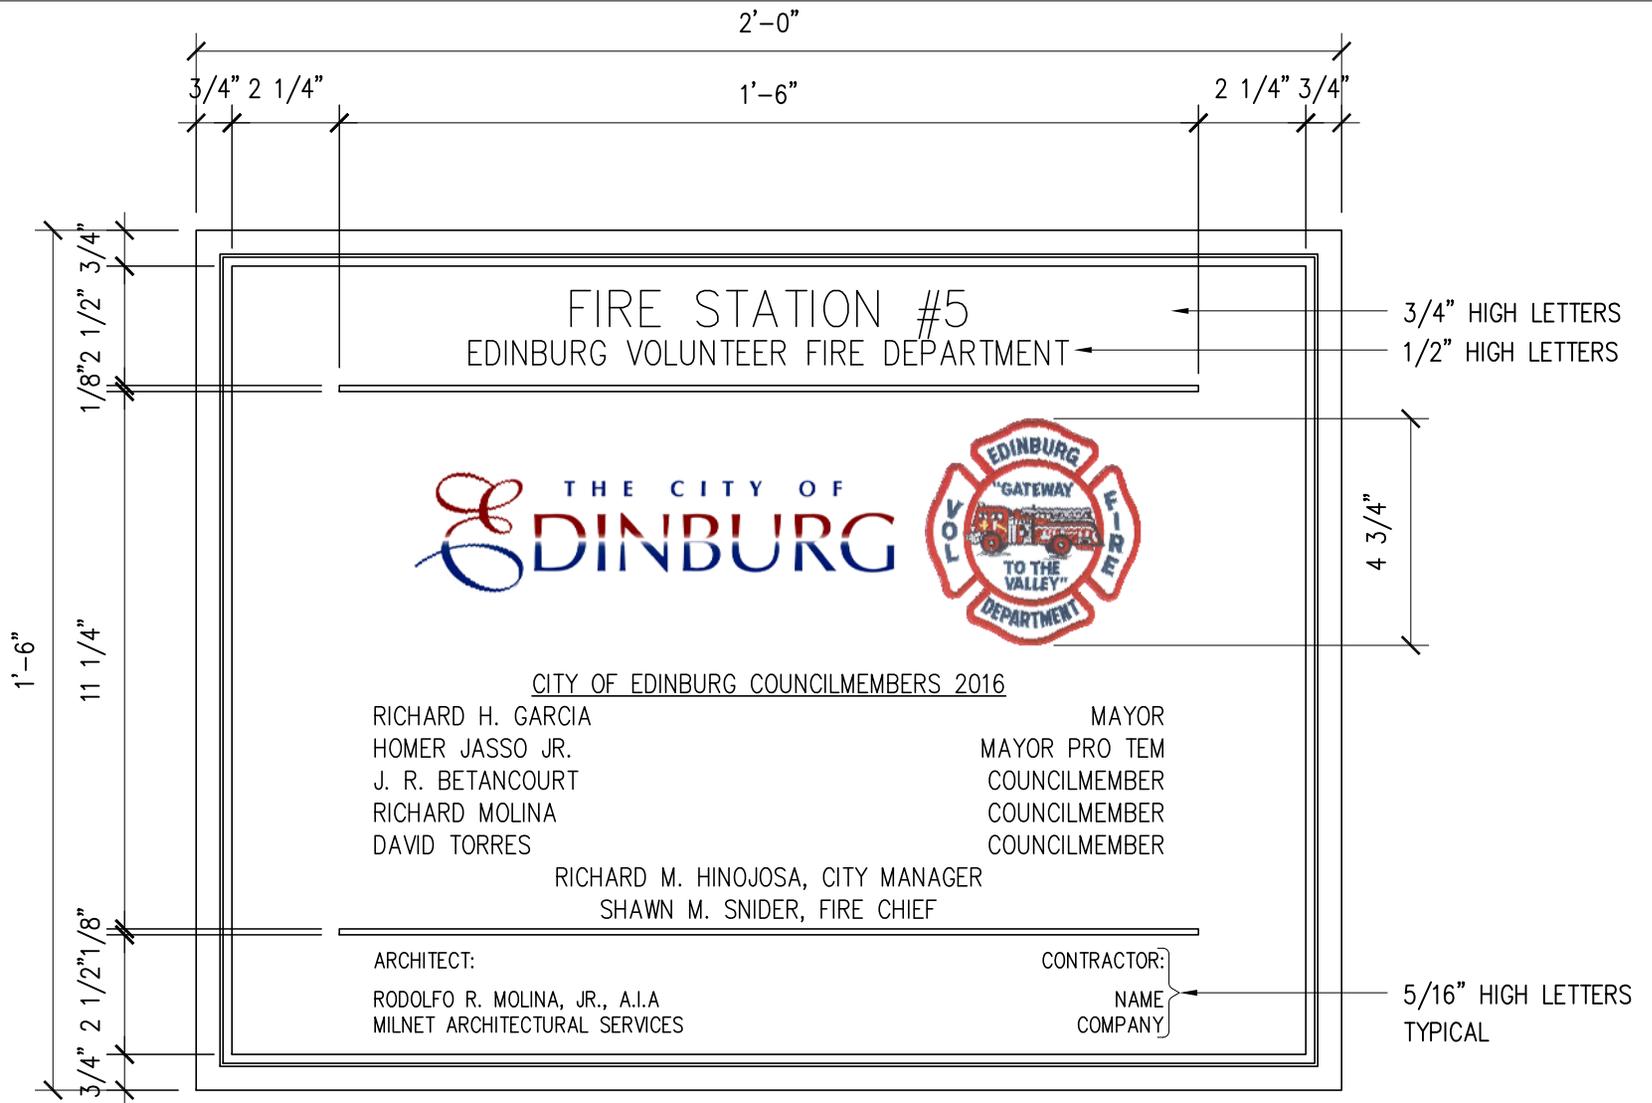

FONT HELVETICA MEDIUM H-709. 3/8" HIGH LETTER UNLESS NOTED OTHERWISE.

1

DETAIL

SCALE: 3" = 1'-0"

A8.0-SK1



MILNET
ARCHITECTURAL
SERVICES


Ph: (956) 688-5656
Fax: (956) 687-9289
Email: milnet@swbell.net

Project Name: CITY OF EDINBURG. FIRE STATION #5

Address: EDINBURG, TEXAS

Date: 1/11/16

Job Number: 214000

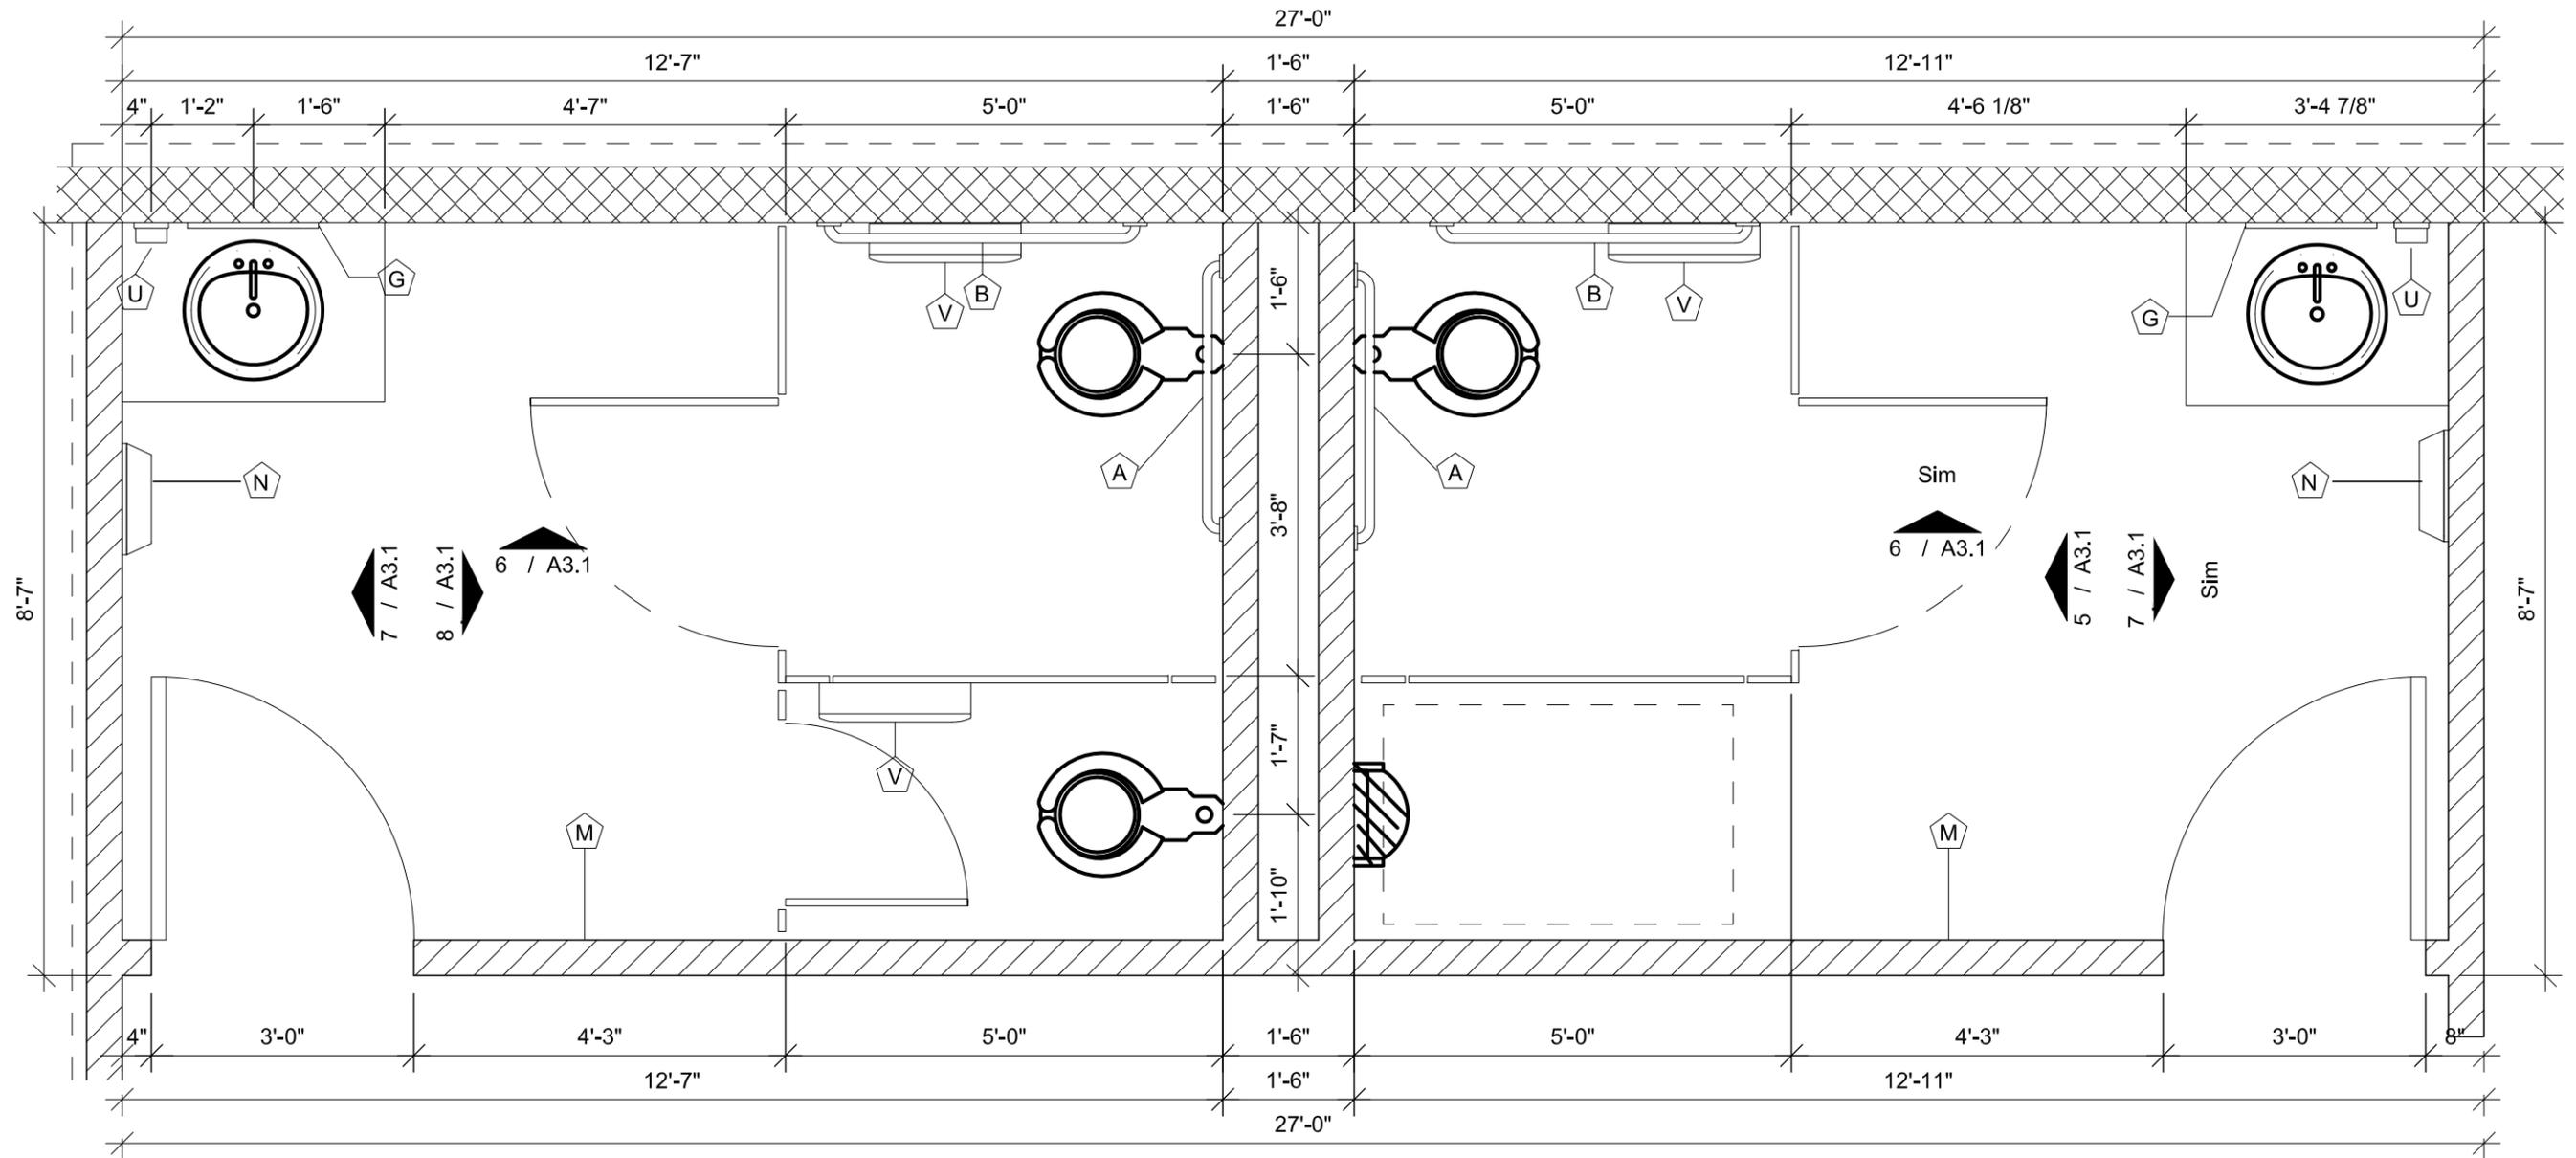

1 RR. ENLARGED PLAN
SCALE: NTS

FROM A3.0
SK1



MILNET
ARCHITECTURAL
SERVICES
Ph: (956) 688-5656
Fax: (956) 687-9289
Email: milnet@swbell.net

Project Name: FIRE STATION #5

Address: CITY OF EDINBURG

Date: 1/7/16

Job Number: 214000



Milnet
Architectural
Services

AMERICAN INSTITUTE OF ARCHITECTS



EDINBURG FIRE STATION #5

CITY OF EDINBURG
JASMAN RD & FM2812

PROJECT NUMBER
214000

DATE
DECEMBER 18, 2015

ISSUED FOR BIDS

S H E E T

A4.0



OF

GENERAL NOTES:

1. ALL OUTLETS SHALL BE @ 15' A.F.F. UNLESS NOTED OTHERWISE. ALSO, OUTLETS SHALL BE PLACED 12'-0" MAX. DISTANCE ALONG INSIDE WALLS.
2. GROUND FAULT INTERRUPTERS (GFI) ARE REQ'D ON CONVENIENCE OUTLETS IN RESTROOMS & KITCHEN.
3. WEATHER PROOF (W.P.) CONVENIENCE OUTLETS ARE REQUIRED OUTSIDE.
4. ALL CLG. ARE 8'-0" A.F.F. UNLESS NOTED OTHERWISE.
5. LIGHT SWITCH @ H.C. RESTROOMS @ 48" O.C. RM #'s: 105, 106, 121 & 122.
6. RE: MEP DWGS. FOR ADDITIONAL INFO.

LEGEND

- [Symbol] PAINTED GYPSUM BOARD
- [Symbol] OPEN STRUCTURE, PAINTED
- [Symbol] TONGUE AND GROOVE CEDAR WOOD PAINTED

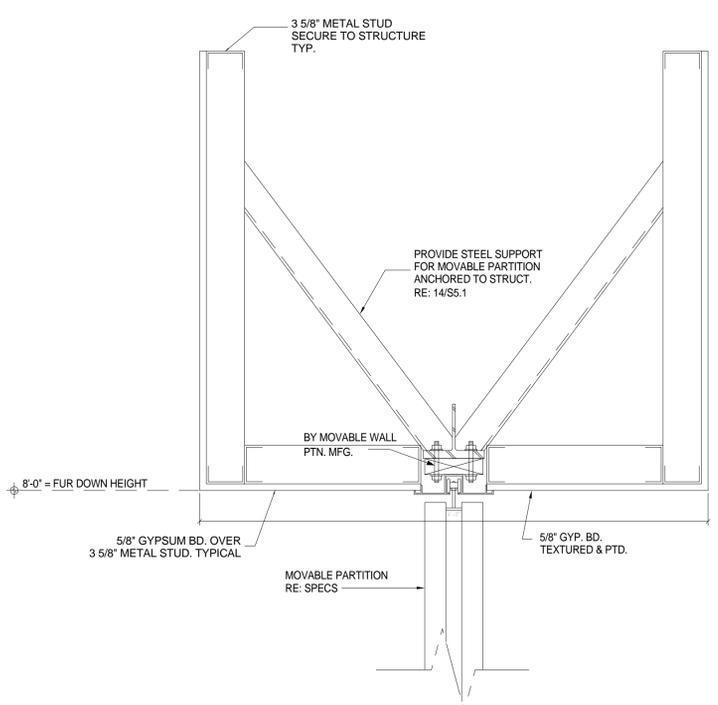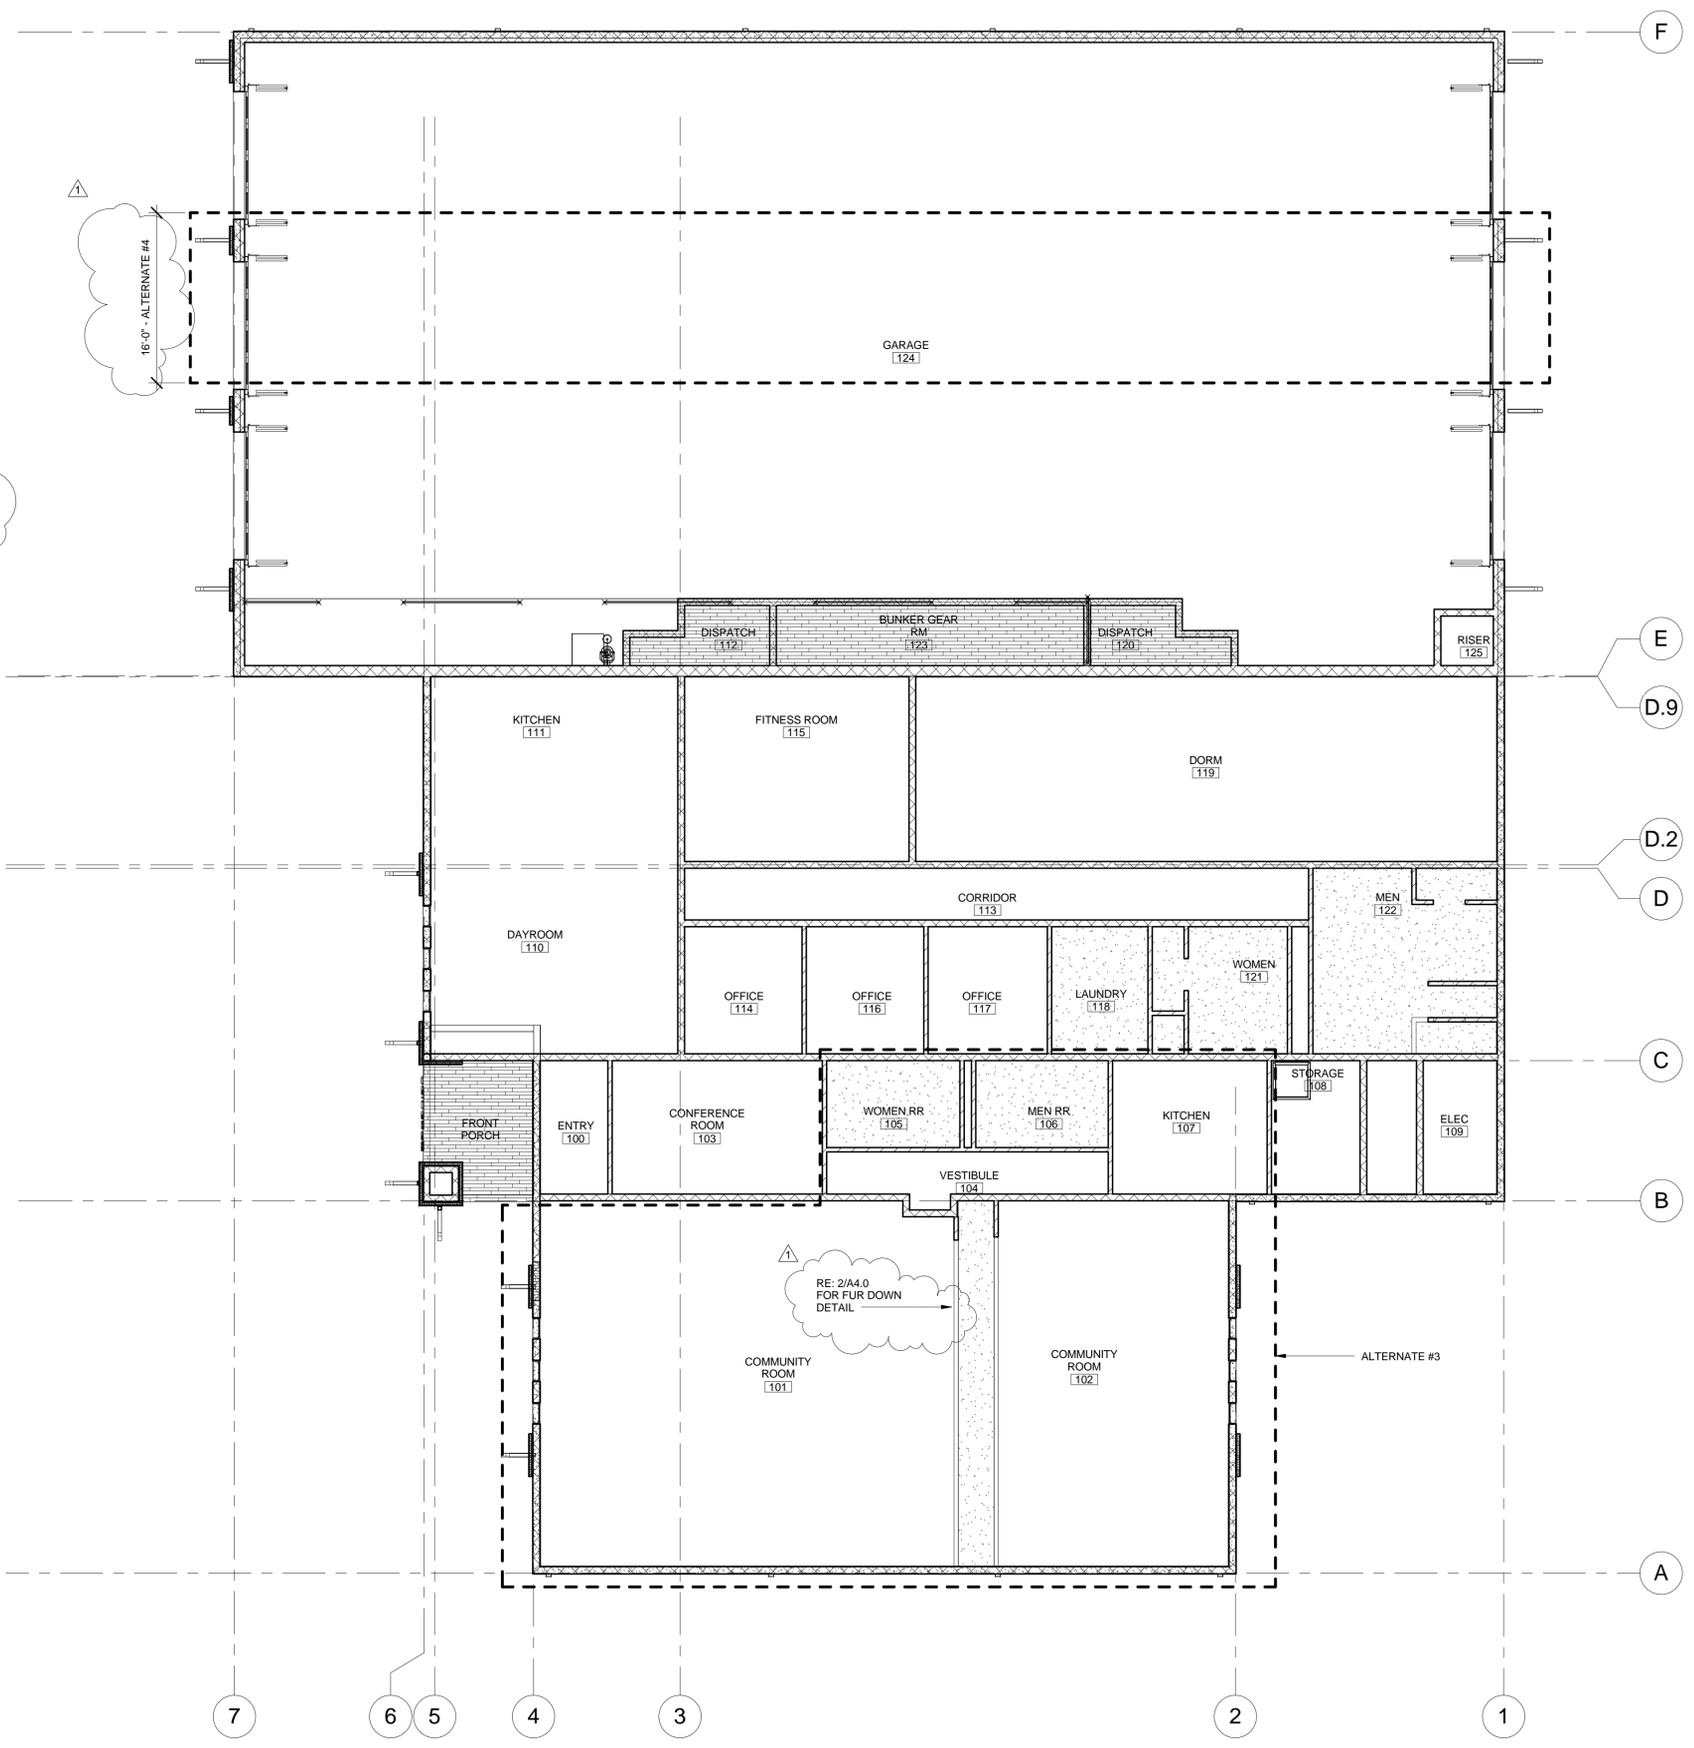


3 FUR DOWN CLG DTL
1 1/2" = 1'-0"

1 CEILING PLAN
1/8" = 1'-0"




Milnet
Architectural
Services


AMERICAN INSTITUTE OF ARCHITECTS

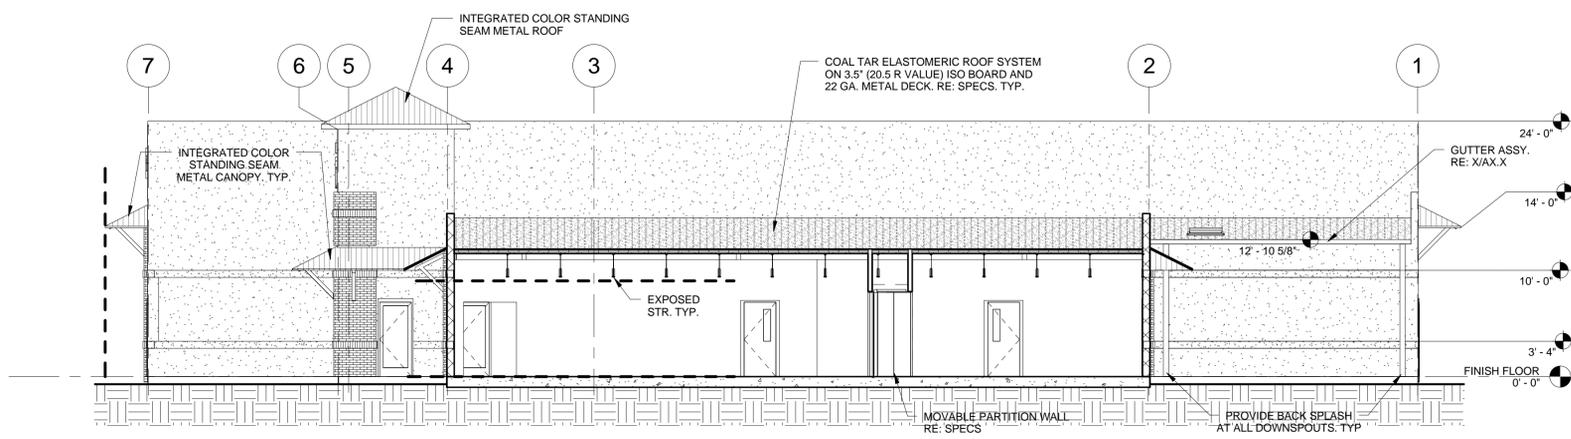


6 BUILDING SECTION
1/8" = 1'-0"

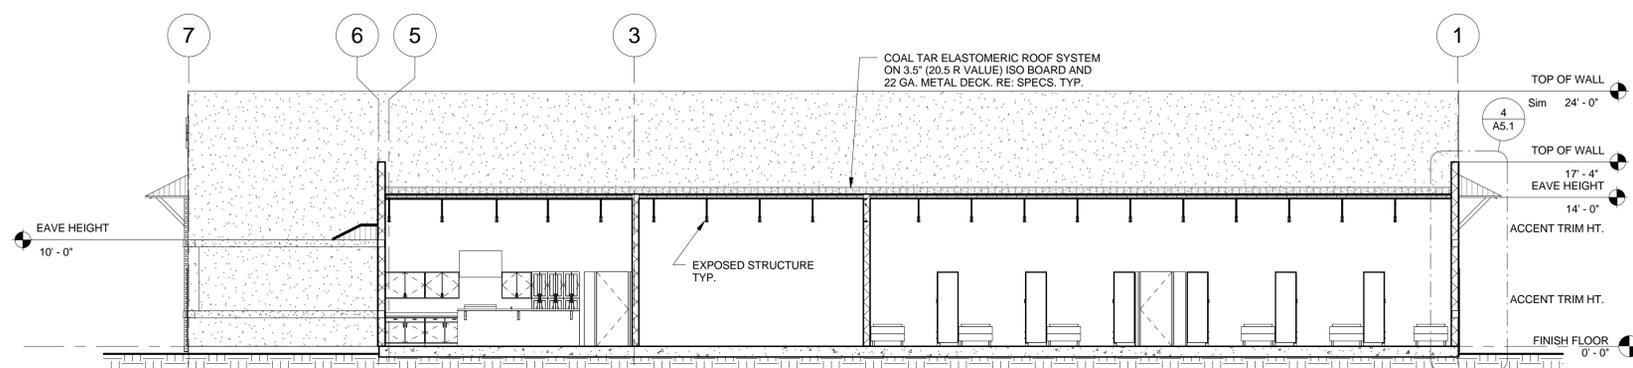


4 BUILDING SECTION
1/8" = 1'-0"

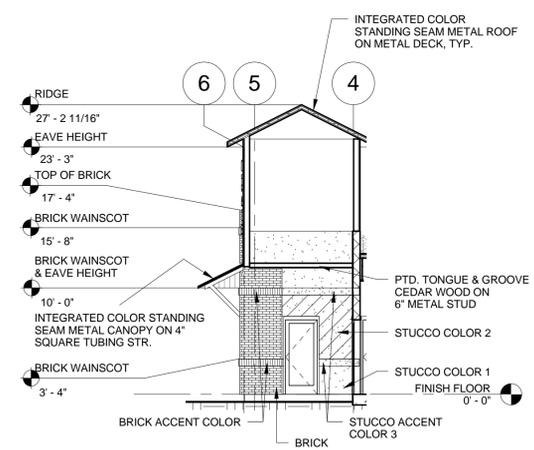


5 BUILDING SECTION
1/8" = 1'-0"

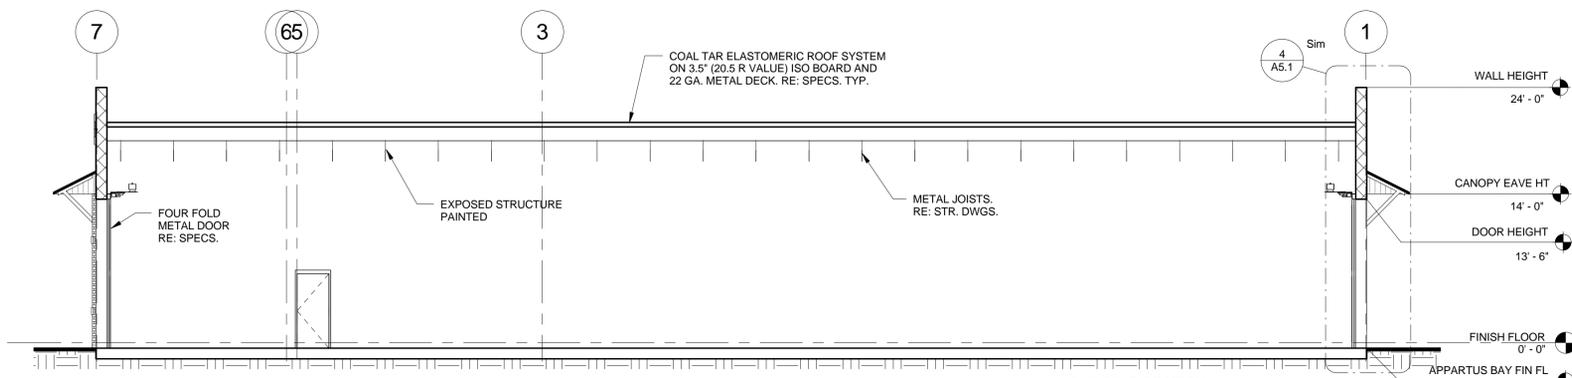

3 BUILDING SECTION
1/8" = 1'-0"

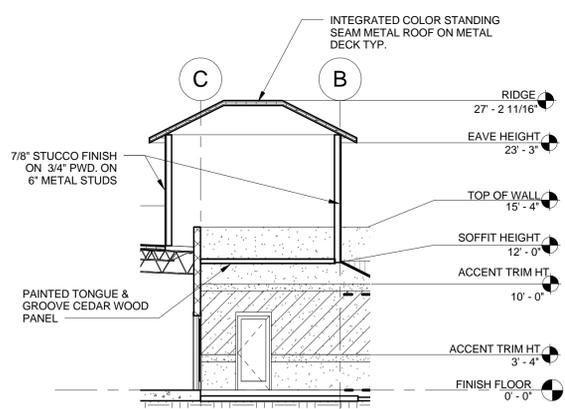

2 BUILDING SECTION
1/8" = 1'-0"

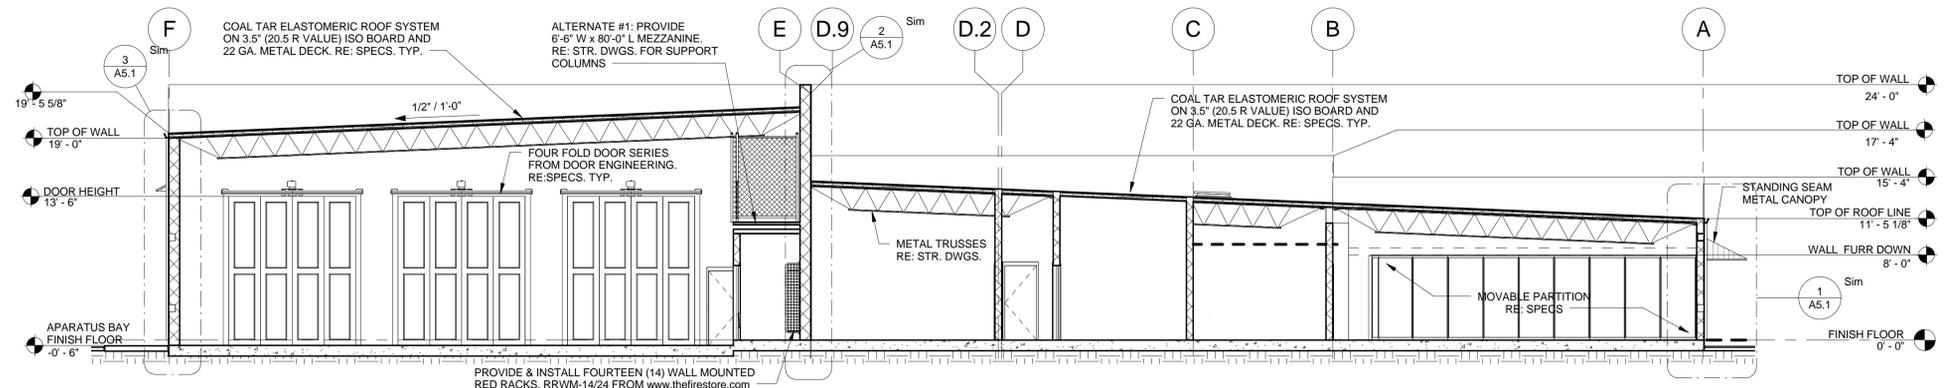

1 BUILDING SECTION
1/8" = 1'-0"

EDINBURG FIRE STATION #5
CITY OF EDINBURG
JASMAN RD & IFM2812


PROJECT NUMBER
214000
DATE
DECEMBER 18, 2015
ISSUED FOR BIDS

SHEET
A5.0
OF

ROOM FINISH SCHEDULE							
ROOM #	DESCRIPTION	FINISH #	WALLS	BASE	FLOOR	CEILING	COMMENTS
100	ENTRY	F1	P-1	B-1	F-1	C-1	
101	COMMUNITY ROOM	F1	P-1	B-1	F-1	C-1	
102	COMMUNITY ROOM	F1	P-1	B-1	F-1	C-1	
103	CONFERENCE ROOM	F1	P-1	B-1	F-1	C-1	
104	VESTIBULE	F1	P-1	B-1	F-1	C-1	
105	WOMEN RR	F3	P-2	B-2	CT	C-2	
106	MEN RR	F3	P-2	B-2	CT	C-2	
107	KITCHEN	F1	P-1	B-1	F-1	C-1	
108	STORAGE	F1	P-1	B-1	F-1	C-1	
109	ELEC	F5	P-1	B-1	SC	C-1	
109A	SERVER RM.	F5	P-1	B-1	SC	C-1	
110	DAYROOM	F1	P-1	B-1	F-1	C-1	
111	KITCHEN	F1	P-1	B-1	F-1	C-1	
112	DISPATCH	F6	P-1	B-1	F-1	C-3	
113	CORRIDOR	F1	P-1	B-1	F-1	C-1	
114	OFFICE	F1	P-1	B-1	F-1	C-1	
115	FITNESS ROOM	F2	P-1	B-1	F-2	C-1	PROVIDE MIRROR FROM 10' TO 8'-0" AFF AT ALL FOUR WALLS
116	OFFICE	F1	P-1	B-1	F-1	C-1	
117	OFFICE	F1	P-1	B-1	F-1	C-1	
118	LAUNDRY	F4	P-1	B-2	CT	C-2	
119	DORM	F1	P-1	B-1	F-1	C-1	
120	DISPATCH	F6	P-1	B-1	F-1	C-3	
121	WOMEN	F3	P-2	B-2	CT	C-2	
121A	CLOSET	F4	P-1	B-2	CT	C-2	
122	MEN	F3	P-2	B-2	CT	C-2	
123	BUNKER GEAR RM	F6	P-1	B-1	F-1	C-3	
124	GARAGE	F5	P-1	B-1	SC	C-1	
125	RISER	F5	P-1	B-1	SC	C-1	

ROOM FINISH STANDARDS		
WALLS	P-1	PAINTED GYPSUM BOARD OR CMU (LATEX PAINT)
	P-2	PAINTED GYPSUM BOARD OR CMU (EPOXY PAINT)
BASE	B-1	4" RUBBER BASE
	B-2	CERAMIC TILE BASE
FLOOR	F-1	POLISHED CONCRETE FLOOR
	F-2	RUBBER TILE FLOORING
	CT	CERAMIC TILE
	SC	SEALED CONCRETE
CEILING	C-1	EXPOSED OPEN CEILING PAINTED
	C-2	PAINTED GYPSUM BOARD (EPOXY PAINT)
	C-3	PAINTED TONGUE & GROOVE CEDAR WOOD PANEL

NOTE: POLISHED CONCRETE FLOOR CUT & SHINE LEVELS:
 CUT LEVEL: GRADE 2, LIGHT EXPOSURE OF COURSE AGGREGATE
 SHINE LEVEL: CLASS 1, 400 GRIT POLISH.
 FINISH COAT: APPLY TWO APPLICATIONS OF SCOFIELD FINISH COAT

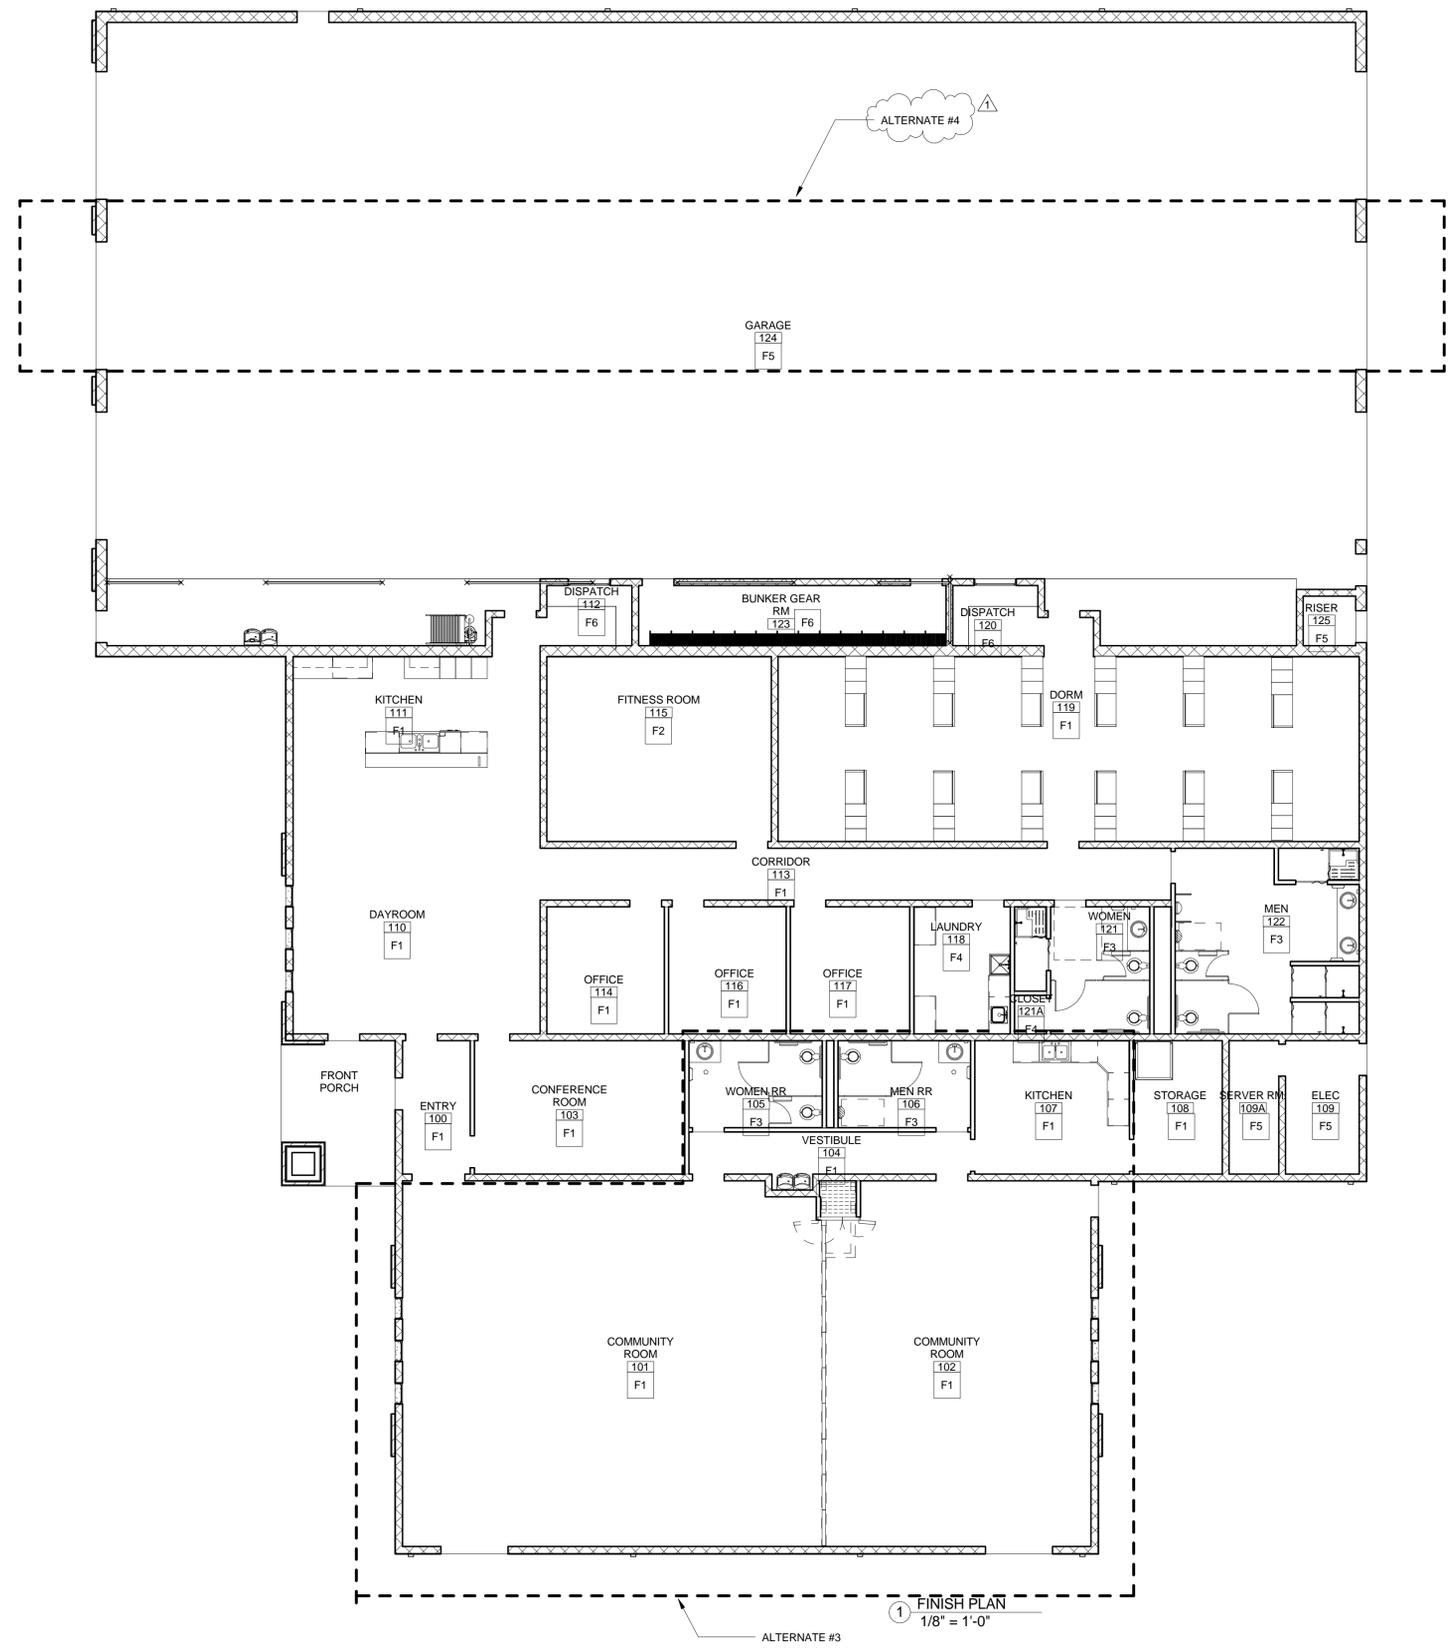

Milnet
Architectural
Services

AMERICAN INSTITUTE OF ARCHITECTS



EDINBURG FIRE STATION #5

CITY OF EDINBURG

JASMAN RD &
FM2812

PROJECT NUMBER
214000

DATE
DECEMBER 18, 2015

ISSUED FOR BIDS

S H E E T

A7.1

OF

SECTION 09910 – PAINTING AND FINISHING

PART 1 - GENERAL

1.1 COORDINATION

- A. The General Conditions of the Contract for Construction and the Supplementary Conditions to the General Conditions of the Contract for Construction shall be considered as part of this section of the specifications.
- B. Each Bidder shall be responsible for determining during the bidding period the extent that any addenda issued during the bidding period may affect this section of the specifications.
- C. Reference Instructions to Bidders for requirements regarding substitutions of materials and products.
- D. Where conflicts occur between the drawings and specifications, between different drawings, between different portions of this section of the specifications, or between different sections of the specifications, the more stringent requirements and the greater quantity shall apply.

1.2 WORK INCLUDED

- A. Provide all labor, materials, and equipment required for all painting, staining and finishing as indicated in the drawings, the approved submittals, and as specified herein. Painted or stained systems include but are not necessarily limited to the items listed below:
- B. EXTERIOR SYSTEMS:
 - 1. All visible wood unless noted otherwise.
 - 2. All ferrous metal. All galvanized metal unless noted otherwise. Touch-up on welds or damaged finishes.
 - 3. Exposed conduit, piping, etc., except for roof mounted piping not visible.
 - 4. Exposed roof mounted equipment visible from ground level or from upper floors of the building.
 - 5. All exposed concrete masonry units.
 - 6. All items normally painted in accordance with good construction practice.
- C. INTERIOR SYSTEMS:
 - 1. All visible wood or behind cabinet doors unless noted otherwise.
 - 2. All ferrous metal. All galvanized metal unless noted otherwise. Touch-up on welds or damaged finishes. Structural steel, steel joists and deck exposed to view except in mechanical rooms.
 - 3. Exposed conduit, piping, outlet boxes, raceways, and panel boxes except galvanized or aluminum piping located in mechanical or electrical rooms.
 - 4. All exposed concrete masonry units, gypsum board and plaster unless otherwise noted.
 - 5. All factory-primed hardware. Back-priming of all wood trim, millwork or finished carpentry prior to installation.
 - 6. All hollow metal doors and frames.
 - 7. All items normally painted in accordance with good construction practice.
 - 8. All unfinished louvers and grilles.

1.3 WORK TYPICALLY EXCLUDED

- A. Shop applied primer on structural steel and miscellaneous metals items.
 - B. Aluminum frames, doors, and windows.
 - C. Plastic clad casework, millwork, and wall panels.
 - D. Factory finished equipment unless noted otherwise (provide job touch-up).
- 1.4 DRAWING REFERENCE: Reference any paint or finish notes in the drawings for any pre-selected colors or other requirements.
- 1.5 SUBMITTALS
- A. Submit manufacturer's product data describing each proposed type of paint, sealer, stain, or coating and its recommended use. Include viscosity and percent solids information. Where not the specified base manufacturer, list the specified brand name and type and the proposed substitute. The Architect shall be the sole judge as to equivalency of systems.
 - B. Reference Section 01340 SUBMITTALS for additional submittal requirements.
- 1.6 WARRANTY
- A. Provide written warranty against defects in materials and workmanship for the work under this section for a period of two years after the date of Substantial Completion of the project.
 - B. Warranted defects shall include but not necessarily be limited to peeling, crazing, cracking, blistering, mildewing, chalking or dusting, pin holes, color fade or loss of hardness or sheen.
- 1.7 QUALITY ASSURANCE
- A. Painting contractor shall have a minimum of 5 years experience in the application of the specified systems for projects of similar size and scope as this project.
 - B. If requested by the Architect, provide system manufacturer's certification of the proposed painting contractor as approved for application of the product.
- 1.8 DELIVERY, STORAGE AND HANDLING
- A. Do not deliver painting materials to the jobsite until spaces and surfaces are ready for painting.
 - B. Deliver materials in manufacturer's original containers, unopened except for shop mixing of colors. Containers shall bear manufacturer's readable labels indicating brand and type of paint. Any additional containers with labels indicating products not approved shall be removed from the jobsite. Any applied material not previously approved by the Architect is subject to removal and reapplication with the appropriate approved product.
 - C. Store materials in environmentally controlled area. Interior products shall be acclimated to a temperature range of 50-80 degrees F. at least 24 hours prior to application.

PART 2 - PRODUCTS

2.1 MANUFACTURERS

- A. TYPICAL PAINTS: Systems are based on the first listed manufacturer. Only equivalent systems provided by specified manufacturers in accordance with attached Product Comparison sheet and as approved by the Architect are approved for use.
1. Sherwin Williams, Inc.
 2. Pittsburgh Paints
 3. Pratt & Lambert
 4. Benjamin Moore Co.
- B. SPECIALTY PAINTS:
1. Epoxies: Sherwin Williams, PPG, Pratt & Lambert.
- C. SUBSTITUTIONS: In accordance with Section 01600 Substitution Procedures.

2.2 INTERIOR SYSTEMS

- A. SYSTEM TYPES FOR NEW WALLS (Unless indicated otherwise on Finish Schedule or drawings):
1. Drywall in toilet rooms, storage rooms, and mechanical/electrical/toilet rooms/ classrooms: **Semi Gloss Enamel** at walls and ceilings.
 2. Drywall soffits: **Eggshell Enamel**.
 3. Typical masonry (CMU): **Gloss Enamel**.
 4. Masonry (CMU) in toilet rooms: **Gloss Epoxy**.
 5. Steel railings: **Gloss Aliphatic Urethane**.
 6. Suspended rigging over stage: **Dry Fog**.
- B. SYSTEM DESCRIPTIONS (Reference item 3.3 for modifications and preparation required for these systems when applied to existing walls already painted):
1. Primer on gypsum board: SW PrepRite High Build Primer B28W601 – one coat over light to medium texture (submit texture sample for approval)
 2. Eggshell Enamel on Drywall: SW Pro Mar 400 Latex Eg-Shel B20W4400 – one coat over specified primer.
 3. Semi-Gloss Enamel on Drywall: SW Pro Mar 400 Latex Semi Gloss B31W4400 - one coat over specified primer.
 4. Epoxy Paint on Drywall: One coat SW PrepRite 200 Latex Primer B28W200 over specified primer.
 5. Gloss Enamel on Drywall: Two coats SW Water Based Catalyzed Epoxy B70 Series gloss acrylic over specified primer.
 6. Semi-Gloss Enamel on shop-primed metals: SW Water Based Industrial Enamel B53-300 acrylic gloss Enamel – two coats.
 7. Natural Finish on Wood: SW Sherwood BAC Wiping Stain (one coat) + SW Wood Classics Sanding Sealer B26V3 (one coat) + SW Wood Classics Satin Varnish A66.
 8. Clear Finish on Wood: SW Wood Classics Polyurethane Varnish A67 (two coats). Sand lightly between all coats.
 9. Block Filler: SW Prep Rite Block Filler B25W25 (for areas not subject to moisture); SW Heavy Duty Block Filler (for areas subject to moisture). Provide 2 coats as specified under “Execution”.

10. Gloss Enamel on CMU or concrete: Two coats block filler plus two coats SW Water based Industrial Enamel gloss acrylic latex over specified primer.
11. Semi-Gloss Enamel on CMU or concrete: Two coats block filler plus two coats SW Water Based Industrial Enamel semi-gloss acrylic latex over specified primer.
12. Semi-Gloss Epoxy Paint on concrete: One coat SW Water Based Epoxy semi-gloss over cured concrete plus finish coat of SW Water Based Epoxy semi-gloss. Minimum paint thickness 3.0 dry mils.
13. Gloss Epoxy Paint on CMU: Two coats block filler (unless surface-bonded) plus finish coat of gloss. Minimum paint thickness 3.0 dry mils.
14. Gloss Epoxy Paint on concrete: One coat SW Water Based Epoxy gloss over cured concrete plus finish coat of SW Water Based Epoxy gloss. Minimum paint thickness 3.0 dry mils.
15. Semi-Gloss Enamel on utility piping and galvanized metals: SW Pro-Cryl Universal Metal Primer – one coat + SW DTM Acrylic Semi Gloss – two coats.
16. Semi-Gloss Epoxy Paint on CMU: Two coats block filler plus finish coat of SW Water Based Epoxy semi-gloss. Minimum paint thickness 3.0 dry mils.
17. Gloss Aliphatic Urethane Enamel on primed steel railings: Over epoxy shop primer apply two coats SW Hydrogloss Single Component Water Based Urethane B65-181 Urethane Gloss Enamel using airless spray equipment.
18. Dry Fall Acrylic (exposed deck, structure and rigging): One coat SW Super Save Lite Acrylic Dry Fall Eggshell Primer & Finish. Black color. Overspray dries to non-adhering dust in a ten foot fall.

2.3 EXTERIOR SYSTEMS

A. SYSTEM TYPES:

1. Exterior Metals: **Gloss Enamel.**
2. Field welds: **Zinc-Rich Coating.**

B. SYSTEM DESCRIPTION:

1. Gloss Enamel on Galvanized Metals: SW Pro-Cryl Universal Metal Primer B66W310 (one coat) + SW Sher-Cryl HPA B66-300 enamel – two coats.
2. Block Filler on CMU: SW Heavy Duty Block Filler B24W46, one coat.
3. Gloss Enamel on Shop-Primed Metals: SW Sher-Cryl HPA B66-300 gloss enamel-two coats.
4. Gloss Enamel on Aluminum: SW Pro-Cryl Universal Metal Primer B66W310 – (one coat) + SW Sher-Cryl HPA B66-300 gloss enamel – two coats.
5. Field Welds: “ZRC” cold-applied galvanizing.

PART 3 - EXECUTION

3.1 PREPARATION

- A. **METALS**: Remove grease, oil, and dirt. Touch-up any damaged primer with like material. Remove any welding tags and grind smooth before painting. Fill any open galvanizing ports.
- B. **PLASTER, CMU, CONCRETE**: Remove dusting and mortar residue. Remove any efflorescence and seal. Ensure that plaster, concrete and mortar joints are dry and fully cured.

3.2 APPLICATION

- A. GENERAL: All paint and finishes be brushed or sprayed in even, uniform coats without runs or sags. Allow each coat to dry completely before applying succeeding coats. All surfaces shall be dry and no painting shall be done in damp conditions or when the ambient temperature is below 50 degrees F.
- B. WOOD DOORS: Factory sealed tops, bottoms, and edges of plastic laminate surfaced doors left undisturbed require no additional finishing. Reseal any job cuts. Paint metal glazing stops.
- C. MECHANICAL/ELECTRICAL EQUIPMENT: Painting contractor shall examine the mechanical and electrical drawings to determine quantities and locations of exposed piping, louvers not shown in Architectural drawings, electrical and telephone panels in finished areas, exposed electrical conduit in finished areas.
- D. BLOCK FILLER AT CMU: Apply **first coat** of filler to ensure penetration into voids and work into block texture with bristle brush. Follow with a **minimum of one additional coat**. Provide uniform finish with no pinholes.
- E. DRYWALL: Paint finish, sheen and texture shall be uniform and match the samples submitted to and approved by the Architect.

3.3 PREPARATION OF EXISTING PAINTED SURFACES

- A. Maintenance painting will frequently not permit or require complete removal of all old coatings prior to repainting. However, all surface contamination such as oil, grease. Loose paint, mill scale dirt, foreign matter, rust, mold, mildew, mortar, efflorescence, and sealers must be removed to assure sound bonding to the tightly adhering old paint. Glossy surfaces of old paint films must be clean and dull before repainting. Thoroughly washing with an abrasive cleanser will clean and dull in one operation, or, wash thoroughly and dull by sanding. Spot prime any bare areas with an appropriate primer. Recognize that any surface preparation short of total removal of the old coating may compromise the service length of the system. Check for compatibility by applying a test patch of the recommended coating system, covering at least 2 to 3 square feet. Allow to dry one week before testing adhesion per ASTM D3359. If the coating system is incompatible, complete removal is required.

PART 4 – SCHEDULES

4.1 COLOR SELECTIONS

- A. SCHEDULE: Unless colors are pre-selected in the Bidding Documents, the Architect shall prepare color schedule for the project using colors selected from the approved paint manufacturer(s). Where colors are pre-selected, the painting contractor shall use the colors selected or submit a schedule of proposed exact color matches by one of the specified paint manufacturers. **Provide 12” x 12” samples of actual paint for each color** whether pre-selected color or proposed color match.
- B. DOCUMENTATION: Upon completion of the Project, painting contractor shall furnish to the Architect a complete schedule of paint brands, types, and colors actually used for each room and area.

4.2 EXTRA MATERIALS

- B. Furnish extra materials that match products installed and that are packaged with protective covering for storage and identified with labels describing contents. Furnish quantity not less than 5 percent for each color (field and accent) of paint used.

END OF SECTION

SECTION 08411 – ALUMINUM STOREFRONTS

PART 1 - GENERAL

1.0 COORDINATION

- A. The General Conditions of the Contract for Construction and the Supplementary Conditions to the General Conditions of the Contract for Construction shall be considered as part of this section of the specifications.
- B. Each Bidder shall be responsible for determining during the bidding period the extent that any addenda issued during the bidding period may affect this section of the specifications.
- C. Reference Instructions to Bidders for requirements regarding substitutions of materials and products.
- D. Where conflicts occur between the drawings and specifications, between different drawings, between different portions of this section of the specifications, or between different sections of the specifications, the more stringent requirements and the greater quantity shall apply.

1.1 SUMMARY

- A. Related Documents: Conditions of the Contract, Division 1 - General Requirements, and Drawings apply to Work of this Section.
- B. Section Includes:
 - 1. Entrance and storefront systems, complete with reinforcing, fasteners, anchors and attachment devices.
 - 2. Aluminum doors complete with hardware.
 - 3. Accessories necessary to complete work.
- C. Related Sections:
 - 1. Section 01400 - Quality Requirements.
 - 2. Section 05500 - Metal Fabrications.
 - 3. Section 06100 - Rough Carpentry.
 - 4. Section 07920 - Joint Sealants.
 - 5. Section 08710 - Door Hardware.
 - 6. Section 08810 - Glass and Glazing.

1.2 REFERENCES

- A. Aluminum Association (AA):
 - 1. DAF-45 Designation System for Aluminum Finishes.
- B. American Architectural Manufacturers Association (AAMA):
 - 1. 503.1 Test Method for Condensation Resistance of Windows, Doors and Glazed Wall Systems.
 - 2. 701.2 Specifications for Pile Weatherstripping.
 - 3. Manual #10 Care and Handling of Architectural Aluminum From Shop to Site.
 - 4. SFM-1 Aluminum Storefront and Entrance Manual.
- C. American National Standards Institute (ANSI):
 - 1. A117.1 Safety Standards for the Handicapped.

- D. American Society for Testing and Materials (ASTM):
1. A36 Structural Steel.
 2. B209 Aluminum and Aluminum - Alloy Sheet and Plate.
 3. B221 Aluminum-Alloy Extruded Bars, Rods, Wire, Shapes and Tubes.
 4. B308 Aluminum-Alloy 6061-T6 Standard Structural Shapes, Rolled or Extruded.
 5. C509 Cellular Elastomeric Pre-formed Gasket and Sealing Material.
 6. C864 Dense Elastomeric Compression Seal Gaskets, Setting Blocks and Spacers.
 7. E283 Test Method for Rate of Air Leakage Through Exterior Windows, Curtain Walls and Doors.
 8. E330 Test Method for Structural Performance of Exterior Windows, Curtain Walls and Doors by Uniform Static Air Pressure Difference.
 9. E331 Test Method for Water Penetration of Exterior Windows, Curtain Walls and Doors by Uniform Static Air Pressure Difference.
- E. Federal Specifications (FS):
1. TT-P-645A Primer, Paint, Zinc Chromate, Alkyd Type.
- F. Steel Structures Painting Council (SSPC):
1. Paint 12 Cold-Applied Asphalt Mastic (Extra Thick Film).

1.3 SYSTEM REQUIREMENTS

- A. Design Requirements:
1. Drawings are diagrammatic and do not purport to identify nor solve problems of thermal or structural movement, glazing, anchorage or moisture disposal.
 2. Requirements shown by details are intended to establish basic dimension of units, sight lines and profiles of members.
 3. Provide concealed fastening.
 4. Provide entrance and storefront systems, including necessary modifications, to meet specified requirements and maintaining visual design concepts.
 5. Attachment considerations are to take into account site peculiarities and expansion and contraction movements so there is no possibility of loosening, weakening or fracturing connection between units and building structure or between units themselves.
 6. Anchors, fasteners and braces shall be structurally stressed not more than 50% of allowable stress when maximum loads are applied.
 7. Provide for expansion and contraction without detriment to appearance or performance.
 8. Assemblies shall be free from rattles, wind whistles and noise due to thermal and structural movement and wind pressure.
- B. Performance Requirements:
1. Air infiltration: Air leakage through fixed light areas of storefront shall not exceed 0.06 cfm per square foot (0.0003 m³/sm²) of surface area when tested in accordance with ASTM E283 at differential static pressure of 6.24 psf (300 Pa).
 2. Water infiltration: No uncontrolled water penetration when tested in accordance with ASTM E 331 at test pressure of 8.0 psf 380 Pa.

- C. Thermal Requirements:
 - 1. Framing systems shall accommodate expansion and contraction movement due to surface temperature differentials of 180 degrees Fahrenheit (82 degrees Celsius) without causing buckling, stress on glass, failure of joint seals, excessive stress on structural elements, reduction of performance, or other detrimental effects.
 - 2. Ensure doors function normally within limits of specified temperature range.
- D. Structural Requirements, as measured in accordance with ANSI/ASTM E330:
 - 1. Wind loads for exterior assemblies:
 - a. Basic loading:
 - 1) [] psf acting inward.
 - 2) [] psf acting outward.
 - 2. Deflection: Maximum calculated deflection of any framing member in direction normal to plane of wall when subjected to specified design pressures shall not exceed 1/175 of its clear span.
- E. Testing Requirements: Provide components that have been previously tested by an independent testing laboratory.

1.4 SUBMITTALS

- A. General: Submit in accordance with Section 01300.
- B. Product Data:
 - 1. Submit manufacturer's descriptive literature and product specifications.
 - 2. Include information for factory finishes, hardware, accessories and other required components.
 - 3. Include color charts for finish indicating manufacturer's standard colors available for selection.
- C. Shop Drawings:
 - 1. Submit shop drawings covering fabrication, installation and finish of specified systems.
 - 2. Include following:
 - a. Fully dimensioned plans and elevations with detail coordination keys.
 - b. Locations of exposed fasteners and joints.
 - 3. Provide detailed drawings of:
 - a. Composite members.
 - b. Joint connections for framing systems and for entrance doors.
 - c. Anchorage.
 - d. System reinforcements.
 - e. Expansion and contraction provisions.
 - f. Hardware, including locations, mounting heights, reinforcements and special installation provisions.
 - g. Glazing methods and accessories.
 - h. Internal sealant requirements as recommended by sealant manufacturer.
 - 4. Schedule of finishes.
- D. Samples:
 - 1. Submit samples indicating quality of finish, in required colors, on alloys used for work, in sizes as standard with manufacturer.
 - 2. Where normal texture or color variations are expected, include additional samples illustrating

range of variation.

E. Test Reports:

1. Standard Systems: Submit certified copies of previous test reports substantiating performance of system in lieu of re-testing. Include other supportive data as necessary.

F. Certificates:

1. Submit manufacturer's certification stating that systems are in compliance with specified requirements.

G. Qualification Data:

1. Submit installer qualifications verifying years of experience.
2. Include list of projects having similar scope of work identified by name, location, date, reference name and phone number.

H. Manufacturer's Instructions: Submit manufacturer's printed installation instructions.

1.5 QUALITY ASSURANCE

A. Single Source Responsibility:

1. To ensure quality of appearance and performance, obtain materials for each system from either a single manufacturer or from manufacturer approved by each system manufacturer.

B. Installer Qualifications: Certified in writing by Contractor as qualified for installation of specified systems.

C. Perform Work in accordance with AAMA SFM-1 and manufacturer's written instructions.

D. Conform to requirements of ANSI A117.1 and local amendments.

1.6 DELIVERY, STORAGE AND HANDLING

A. Comply with requirements of Section 01600.

B. Protect finished surfaces as necessary to prevent damage.

C. Do not use adhesive papers or sprayed coatings which become firmly bonded when exposed to sun.

D. Do not leave coating residue on any surfaces.

E. Replace damaged units.

1.7 WARRANTY

A. Provide warranties in accordance with Section 01700.

B. Provide written manufacturer's warranty, executed by company official, warranting against defects in materials and products for two (2) years from date of Substantial Completion.

C. Provide written installer's warranty, warranting work to be watertight, free from defective materials, defective workmanship, glass breakage due to defective design, and agreeing to replace components which fail within 1 year from date of Substantial Completion.

1. Warranty shall cover following:

- a. Complete watertight and airtight system installation within specified tolerances.

- b. Completed installation will remain free from rattles, wind whistles and noise due to thermal and structural movement and wind pressure.
- c. System is structurally sound and free from distortion.
- d. Glass and glazing gaskets will not break or "pop" from frames due to design wind, expansion or contraction movement.
- e. Glazing sealants and gaskets will remain free from abnormal deterioration or dislocation due to sunlight, weather or oxidation.

PART 2 - PRODUCTS

2.1 MANUFACTURERS AND PRODUCTS

- A. Subject to compliance with requirements indicated, provide products by one of the following:
 - 1. United States Aluminum, 200 Singleton Drive, Waxahachie, Texas 75165; (972) 937-9651 (voice); (972) 937-0405 (data).
- B. Substitutions: Submit under provisions of Section 01600, a minimum of 7 days prior to bid date.
- C. Acceptable Entrance Doors:
 - 1. Standard Duty Doors: Series 550 with Mid-panel panic device system.
- D. Acceptable Storefront Framing Systems:
 - 1. Framing System: Series 450.

2.2 FRAMING MATERIALS AND ACCESSORIES

- A. Aluminum:
 - 1. ASTM B221, alloy 6063-T5 for extrusions; ASTM B209, alloy 5005-H34 for sheets; or other alloys and temper recommended by manufacturer appropriate for specified finish.
- B. [Internal Reinforcing:
 - 1. ASTM A36 for carbon steel; or ASTM B308 for structural aluminum.
 - 2. Shapes and sizes to suit installation.
 - 3. Shop coat steel components after fabrication with alkyd type zinc chromate primer complying with FS TT-P-645.]
- C. Anchorage Devices:
 - 1. Manufacturer's standard formed or fabricated steel or aluminum assemblies of shapes, plates, bars or tubes.
- D. Fasteners:
 - 1. Aluminum, non-magnetic stainless steel or other materials warranted by manufacturer to be non-corrosive and compatible with components being fastened.
 - 2. Do not use exposed fasteners, except where unavoidable for application of hardware.
 - 3. For exposed locations, provide countersunk Phillips head screws with finish matching items fastened.
 - 4. For concealed locations, provide manufacturer's standard fasteners.
 - 5. Provide nuts or washers of design having means to prevent disengagement; deforming of fastener threads is unacceptable.
- E. Expansion Anchor Devices: Lead-shield or toothed-steel, drilled-in, expansion bolt anchors.

- F. Protective Coatings: Cold-applied asphalt mastic complying with SSPC-Paint 12, compounded for 30 mil (0.77 mm) thickness for each coat; or alkyd type zinc chromate primer complying with FS TT-P-645.
- G. Glazing Gaskets:
 - 1. Compression type design, replaceable, molded or extruded, of neoprene, or ethylene propylene diene monomer (EPDM).
 - 2. Conform to ASTM C509 or C864.
 - 3. Profile and hardness as required to maintain uniform pressure for watertight seal.
 - 4. Provide in manufacturer's standard black color.
- H. Weatherstripping:
 - 1. Wool pile conforming to AAMA 701.2; or extruded EPDM elastomeric conforming to ASTM C509 or C864.
 - 2. Provide EPDM or vinyl-blade gasket weatherstripping in bottom door rail, adjustable for contact with threshold.
- I. Internal Sealants: Types recommended by sealant manufacturer.
- J. "Anti-Walk" Edge Blocking: "W" shaped EPDM blocks for use in keeping glazing material stationary under vibration or seismic loading.
- K. Baffles (at weep holes): Type as recommended by system manufacturer and shown in published installation instructions.

2.3 GLASS AND GLAZING ACCESSORIES

- A. Refer to Section 08810.

2.4 FABRICATION

- A. Coordination of Fabrication:
 - 1. Check actual frame or door openings required in construction work by accurate field measurements before fabrication.
 - 2. Fabricate units to withstand loads which will be applied when system is in place.
- B. General:
 - 1. Conceal fasteners wherever possible.
 - 2. Reinforce work as necessary for performance requirements and for support to structure.
 - 3. Separate dissimilar metals and aluminum in contact with concrete utilizing protective coating or pre-formed separators which will prevent contact and corrosion.
 - 4. Comply with Section 08810 for glazing requirements.
- C. Aluminum Framing:
 - 1. Provide members of size, shape and profile indicated, designed to provide for glazing from interior.
 - 2. Fabricate frame assemblies with joints straight and tight fitting.
 - 3. Reinforce internally with structural members as necessary to support design loads.
 - 4. Maintain accurate relation of planes and angles, with hairline fit of contacting members.
 - 5. Seal horizontals and direct moisture accumulation to exterior.
 - 6. Provide flashings and other materials used internally or externally that are corrosive resistant, non-staining, non-bleeding and compatible with adjoining materials.
 - 7. Provide manufacturer's extrusions and accessories to accommodate expansion and contraction due to temperature changes without being

- detrimental to appearance or performance.
8. Make provisions in framing for minimum edge clearance, nominal edge cover and nominal pocket width for thickness and type of glazing or infill used in accordance with recommendations of manufacturer and FGMA Glazing Manual.
 9. Provide tight fitting, injection molded, plastic water deflectors at all intermediate horizontals.

D. Entrance Doors:

1. Fabricate with mechanical joints using internal reinforcing plates and shear blocks attached with fasteners and by welding.
2. Provide extruded aluminum glazing stops of [square] [beveled and mitered (for single glazing only)] design, [permanently anchored on security side and removable on opposite side.]

E. Hardware:

1. Receive hardware supplied in accordance with Section 08710 and install in accordance with requirements of this Section.
2. Cut, reinforce, drill and tap frames and doors as required to receive hardware.
3. Comply with hardware manufacturer's templates and instructions.
4. Use concealed fasteners wherever possible.

F. Welding:

1. Comply with recommendations of the American Welding Society.
2. Use recommended electrodes and methods to avoid distortion and discoloration.
3. Grind exposed welds smooth and flush with adjacent surfaces; restore mechanical finish.

G. Flashings: Form from sheet aluminum with same finish as extruded sections. Apply finish after fabrication. Material thickness as required to suit condition without deflection or "oil-canning".

2.5 FINISH

- A. Manufacturer's standard colors as selected by Architect.

PART 3 - EXECUTION

3.1 EXAMINATION

- A. Examine conditions and proceed with Work in accordance with Section 01400.
- B. Verify dimensions, tolerances and method of attachment with other Work.

3.2 INSTALLATION

A. Erection Tolerances:

1. Limit variations from plumb and level:
 - a. 1/8 inch (3 mm) in 10 feet (3 M) vertically.
 - b. 1/8 inch (3 mm) in 20 feet (6 M) horizontally.
2. Limit variations from theoretical locations: 1/4 inch (6 mm) for any member at any location.
3. Limit offsets in theoretical end-to-end and edge-to-edge alignment: 1/16 inch (2 mm) from flush surfaces not more than 2 inches (51 mm) apart or out-of-flush by more than 1/4 inch (6 mm).

- B. Install doors and hardware in accordance with manufacturer's printed instructions.

- C. Set units plumb, level and true to line, without warp or rack of frame.
- D. Anchor securely in place, allowing for required movement, including expansion and contraction.
- E. Separate dissimilar materials at contact points, including metal in contact with masonry or concrete surfaces, with bituminous paint or pre-formed separators to prevent contact and corrosion.
- F. Seal perimeter members as shown on manufacturer's installation instructions or as required for unique job conditions. Set other members with internal sealants and baffles as called for in manufacturer's installation instructions. Use sealants as recommended by sealant manufacturer.
- G. Coordinate installation of perimeter sealant and backing materials between assemblies and adjacent construction in accordance with requirements of Section 07920.
- H. Glazing: Refer to requirements of Section 08810. Utilize "anti-walk" edge blocking on all vertical edges of glazing.

3.3 ADJUSTING

- A. Test door operating functions. Adjust closing and latching speeds and other hardware in accordance with manufacturer's instructions to ensure smooth operation.

3.4 CLEANING

- A. Clean surfaces in compliance with manufacturer's recommendations; remove excess mastic, mastic smears, foreign materials and other unsightly marks.
- B. Clean metal surfaces exercising care to avoid damage.

END OF SECTION

SECTION 08730 — THRESHOLDS, WEATHERSTRIPPING AND SEALS

PART 1 - GENERAL

1.1 COORDINATION

- A. The General Conditions of the Contract for Construction and the Supplementary Conditions to the General Conditions of the Contract for Construction shall be considered as part of this section of the specifications.
- B. Each Bidder shall be responsible for determining during the bidding period the extent that any addenda issued during the bidding period may affect this section of the specifications.
- C. Reference Instructions to Bidders for requirements regarding substitutions of materials and products.
- D. Where conflicts occur between the drawings and specifications, between different drawings, between different portions of this section of the specifications, or between different sections of the specifications, the more stringent requirements and the greater quantity shall apply.

1.2 WORK INCLUDED

- A. Provide and install thresholds. Weatherstripping, door sweeps, and sound seals as scheduled or indicated on the drawings and as specified herein.
- B. All exterior doors shall receive thresholds, weatherstripping and door sweeps whether or not indicated on the drawings.

1.3 RELATED WORK SPECIFIED IN OTHER SECTIONS

- A. Doors and frames.

1.4 SUBMITTALS

- A. Submit manufacturer's product literature indicating model numbers, configurations and materials.
- B. Upon request submit sample sections of thresholds or seals.
- C. Reference Section 01340 SUBMITTALS for additional submittal requirements.

1.5 WARRANTY

- A. Provide written warranty against defects in materials and workmanship for the work under this section for a period of one year after the date of Substantial Completion of the project.

1.6 QUALITY ASSURANCE

- A. Installer shall have a minimum of 3 years experience in the installation of thresholds, weatherstripping and seals for projects of similar size and scope as this project.

PART 2 - PRODUCTS

2.1 MANUFACTURERS

- A. National Guard.
- B. A. J. May Co.
- C. Zero International, Inc.
- D. Balco, Inc.
- E. Metalines

2.2 MATERIALS

- A. GENERAL: Items specified below are from the catalog of the particular manufacturer named for each item. Equivalent products by other specified manufacturers shall match dimensions and profiles of the scheduled items.
- B. METAL THRESHOLDS: Shall be extruded mill finished aluminum thresholds complete with 1/4" stainless steel machine screws set in expansion anchors. Provide sizes and configurations as indicated in the drawings and as manufactured by A.J. May. Profiles and dimensions shall comply with state and federal regulations for the elimination of Architectural Barriers.
- C. WEATHERSTRIPPING: At all exterior hollow metal doors, provide cushion weatherstripping as manufactured by A.J. May or equivalent by specified manufacturer.
- D. DRIP CAP: At all exterior hollow metal doors not protected with overhang, provide aluminum duranodic drip cap as manufactured by A.J. May or equivalent by specified manufacturer. Mount on frame over door head. Mount in bed of silicone.
- E. DOOR SWEEP: At all exterior hollow metal doors and aluminum doors, provide No.198NDkB duranodic aluminum/neoprene door bottom weather seal as manufactured by National Guard or equivalent by specified manufacturer.

PART 3 - EXECUTION

3.1 INSTALLATION

- A. THRESHOLDS: Install metal thresholds in solid bed of clear silicone rubber sealant using specified anchors with stainless steel screws. Field cut ends of thresholds to fit neatly around door frame configurations.
- B. OTHER: Install weatherstripping, drip caps, door sweeps and seals with stainless steel screws in accordance with manufacturer's printed instructions. Set items in a bed of clear silicone rubber sealant.

3.2 ADJUSTING

- A. Adjust all items for continuous snug contact to prevent water entry.

END OF SECTION



ADDENDUM No. 1
Civil Items


PROJECT: EDINBURG FIRE STATION #5

January 7, 2016

Civil Items:

1. **C2** – Replace sheet C2 dated 9-16-15 with attached sheet C2 dated 1-07-16.
2. **C2A** – Add Sheet C2A “Proposed Site Plan Layout – Alternates” to the Contract documents. See attached.
3. **C3** – Replace sheet C3 dated 9-16-15 with attached sheet C3 dated 1-07-16.
4. **C3A** – Add Sheet C2A “Proposed Striping Plan Layout – Alternates” to the Contract documents. See attached.
5. **C4** – Replace sheet C4 dated 9-16-15 with attached sheet C4 dated 1-07-16.
6. **C4A** – Add Sheet C4A “Proposed Grading and Drainage Plan Layout – Alternate #3” to the Contract documents. See attached.
7. **C5** – Replace sheet C5 dated 9-16-15 with attached sheet C5 dated 1-07-16.
8. **C5A** – Add Sheet C5A “Proposed Utility Layout – Alternates” to the Contract documents. See attached.
9. **C7** – Replace sheet C7 dated 9-16-15 with attached sheet C7 dated 1-07-16.
Paving details revised, curb and gutter detail revised, and monolithic curb detail added.
10. Monolithic curb may be constructed in concrete pavement drives. Standard curb and gutter to be constructed in asphalt pavement areas. Refer to details sheet C7.


END of Addendum No. 1 Civil Items

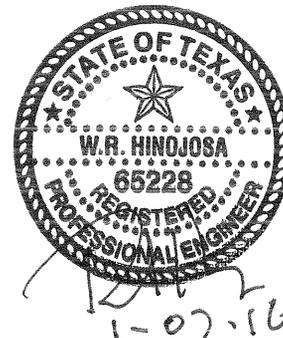



Milnet
Architectural
Services

AMERICAN INSTITUTE OF ARCHITECTS

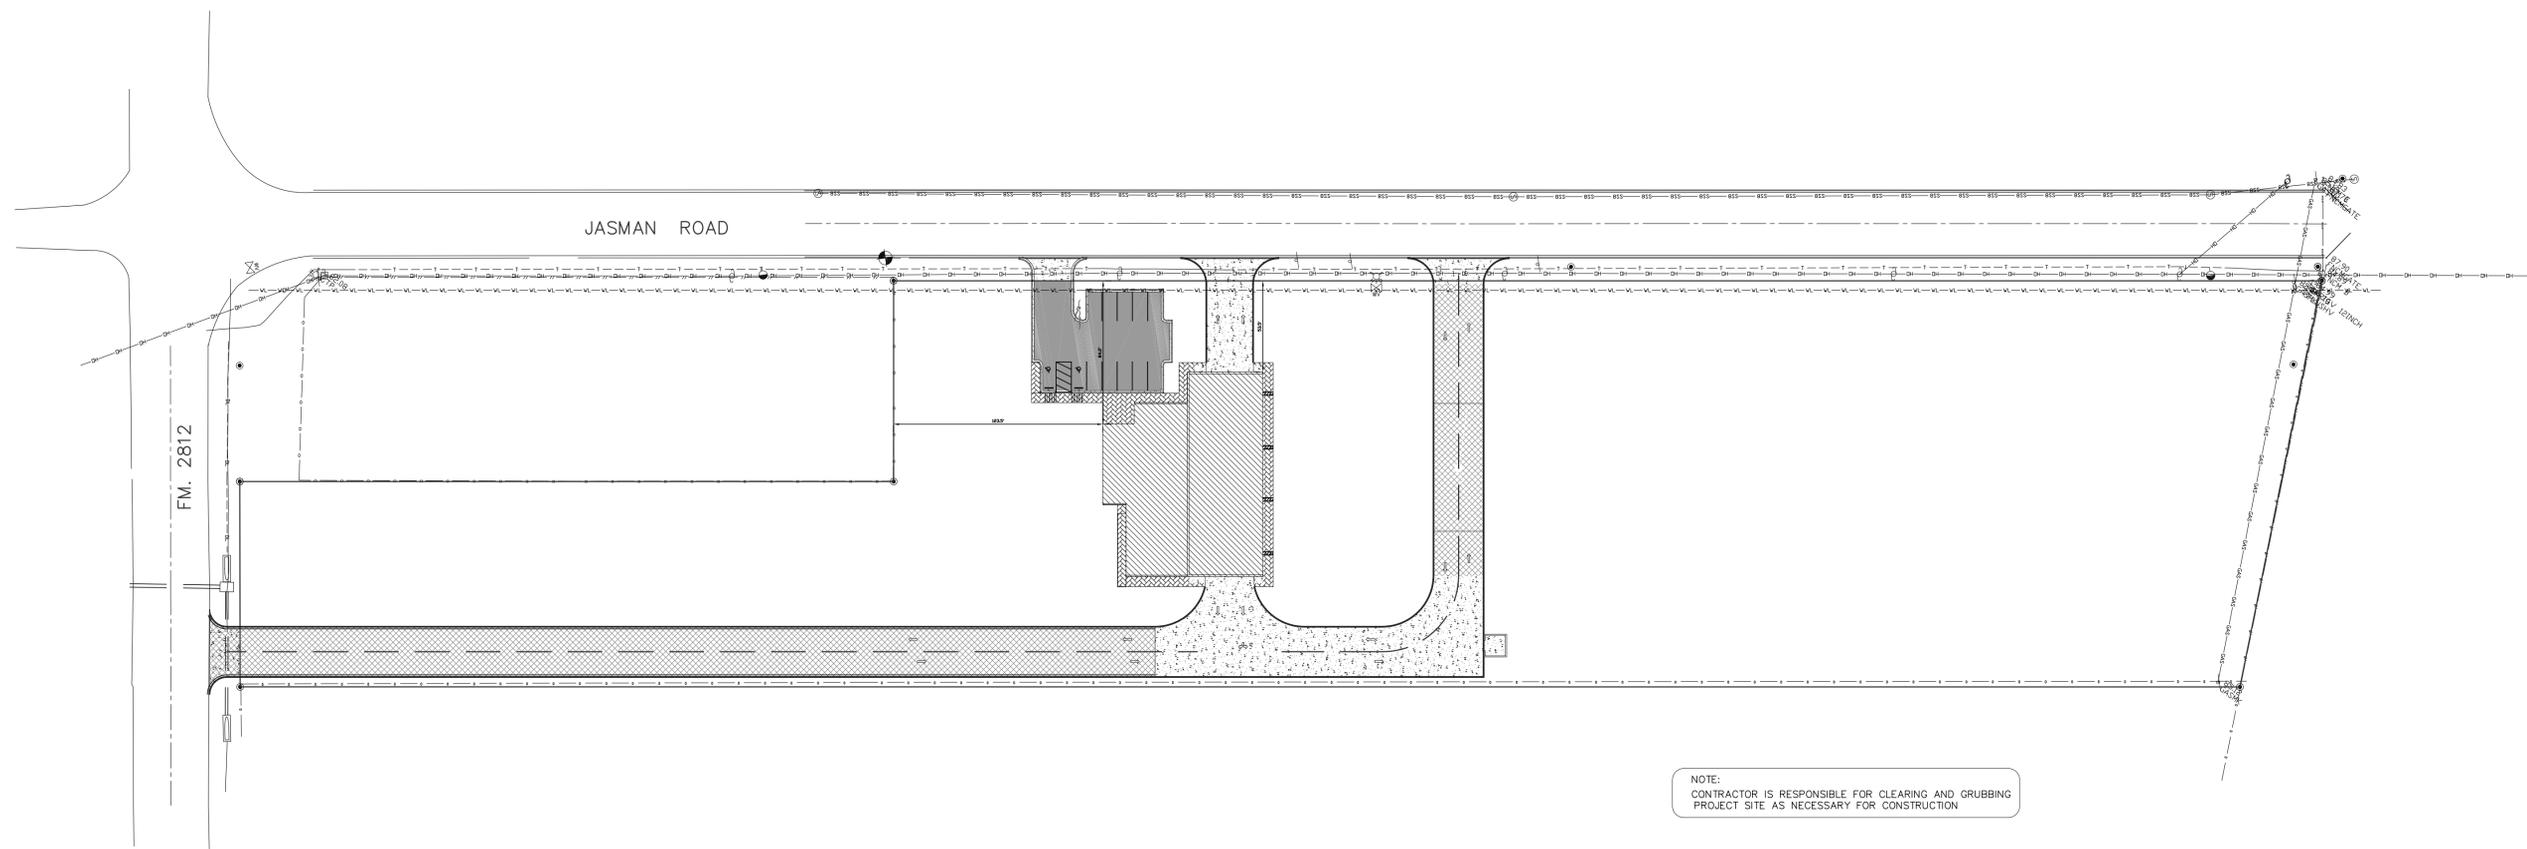


NOTE:
CONTRACTOR IS RESPONSIBLE FOR CLEARING AND GRUBBING
PROJECT SITE AS NECESSARY FOR CONSTRUCTION

- LEGEND
- PROPOSED CONC. PVMT.
 - PROPOSED HMAC PVMT.
 - PROPOSED HEAVY DUTY HMAC PVMT.
 - PROPOSED CONC. SIDE WALK
 - PROPOSED ELEVATION CONTOUR

PROPOSED SITE PLAN LAYOUT

SCALE: 1"=50'

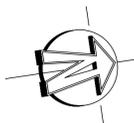

HINOJOSA ENGINEERING, INC.
 STRUCTURAL ENGINEERING
 CIVIL ENGINEERING • LAND SURVEYING
 108 W. 18TH ST. MISSION, TEXAS
 (956) 581-0143 FAX: (956) 581-2074
 E-MAIL: HinojosaEngInc@aol.com
 REGISTRATION NUMBER F-908 EXPIRATION DATE 9/30/2016

EDINBURG FIRE STATION # 5

CITY OF EDINBURG
JASMAN RD & FM 2812

PROJECT NUMBER
15-119
DATE
09-16-2015
ADDENDUM #1 1-07-16

S H E E T


C2

OF



Milnet
Architectural
Services

AMERICAN INSTITUTE OF ARCHITECTS

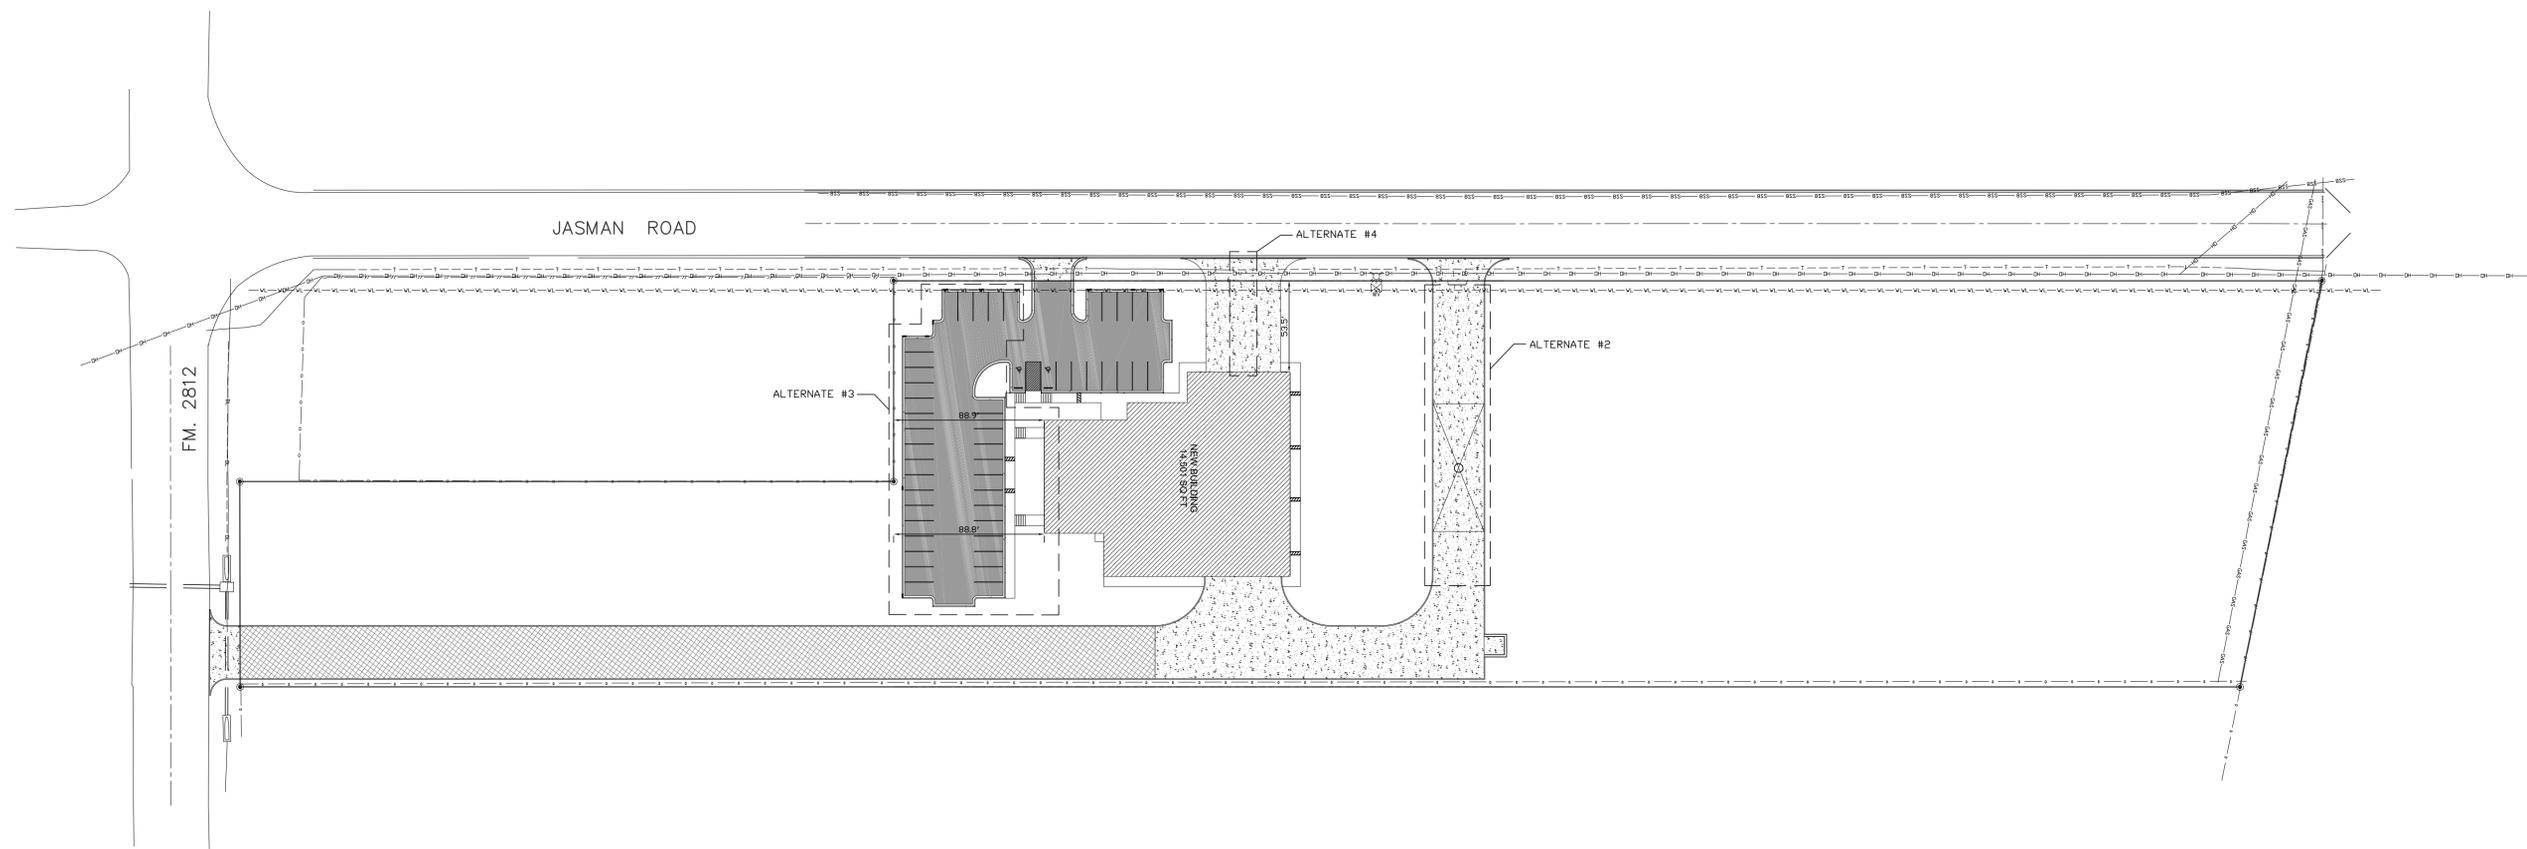

- LEGEND
- PROPOSED CONC. P.VMT.
 - PROPOSED HMAC P.VMT.
 - PROPOSED HEAVY DUTY HMAC P.VMT.
 - PROPOSED CONC. SIDE WALK

NOTE:
CONTRACTOR IS RESPONSIBLE FOR CLEARING AND GRUBBING
PROJECT SITE AS NECESSARY FOR CONSTRUCTION



PROPOSED SITE PLAN LAYOUT - ALTERNATES

SCALE: 1"=50'




HINOJOSA ENGINEERING, INC.
 STRUCTURAL ENGINEERING
 CIVIL ENGINEERING • LAND SURVEYING
 108 W. 18TH ST. MISSION, TEXAS
 (956) 581-0143 FAX: (956) 581-2074
 E-MAIL: HinojosaEngInc@aol.com
 REGISTRATION NUMBER F-908 EXPIRATION DATE 9/30/2016

EDINBURG FIRE STATION # 5
CITY OF EDINBURG
JASMAN RD & FM 2812

PROJECT NUMBER
15-119
DATE
09-16-2015
ADDENDUM #1 1-07-16



S H E E T
C2A
OF

JASMAN ROAD

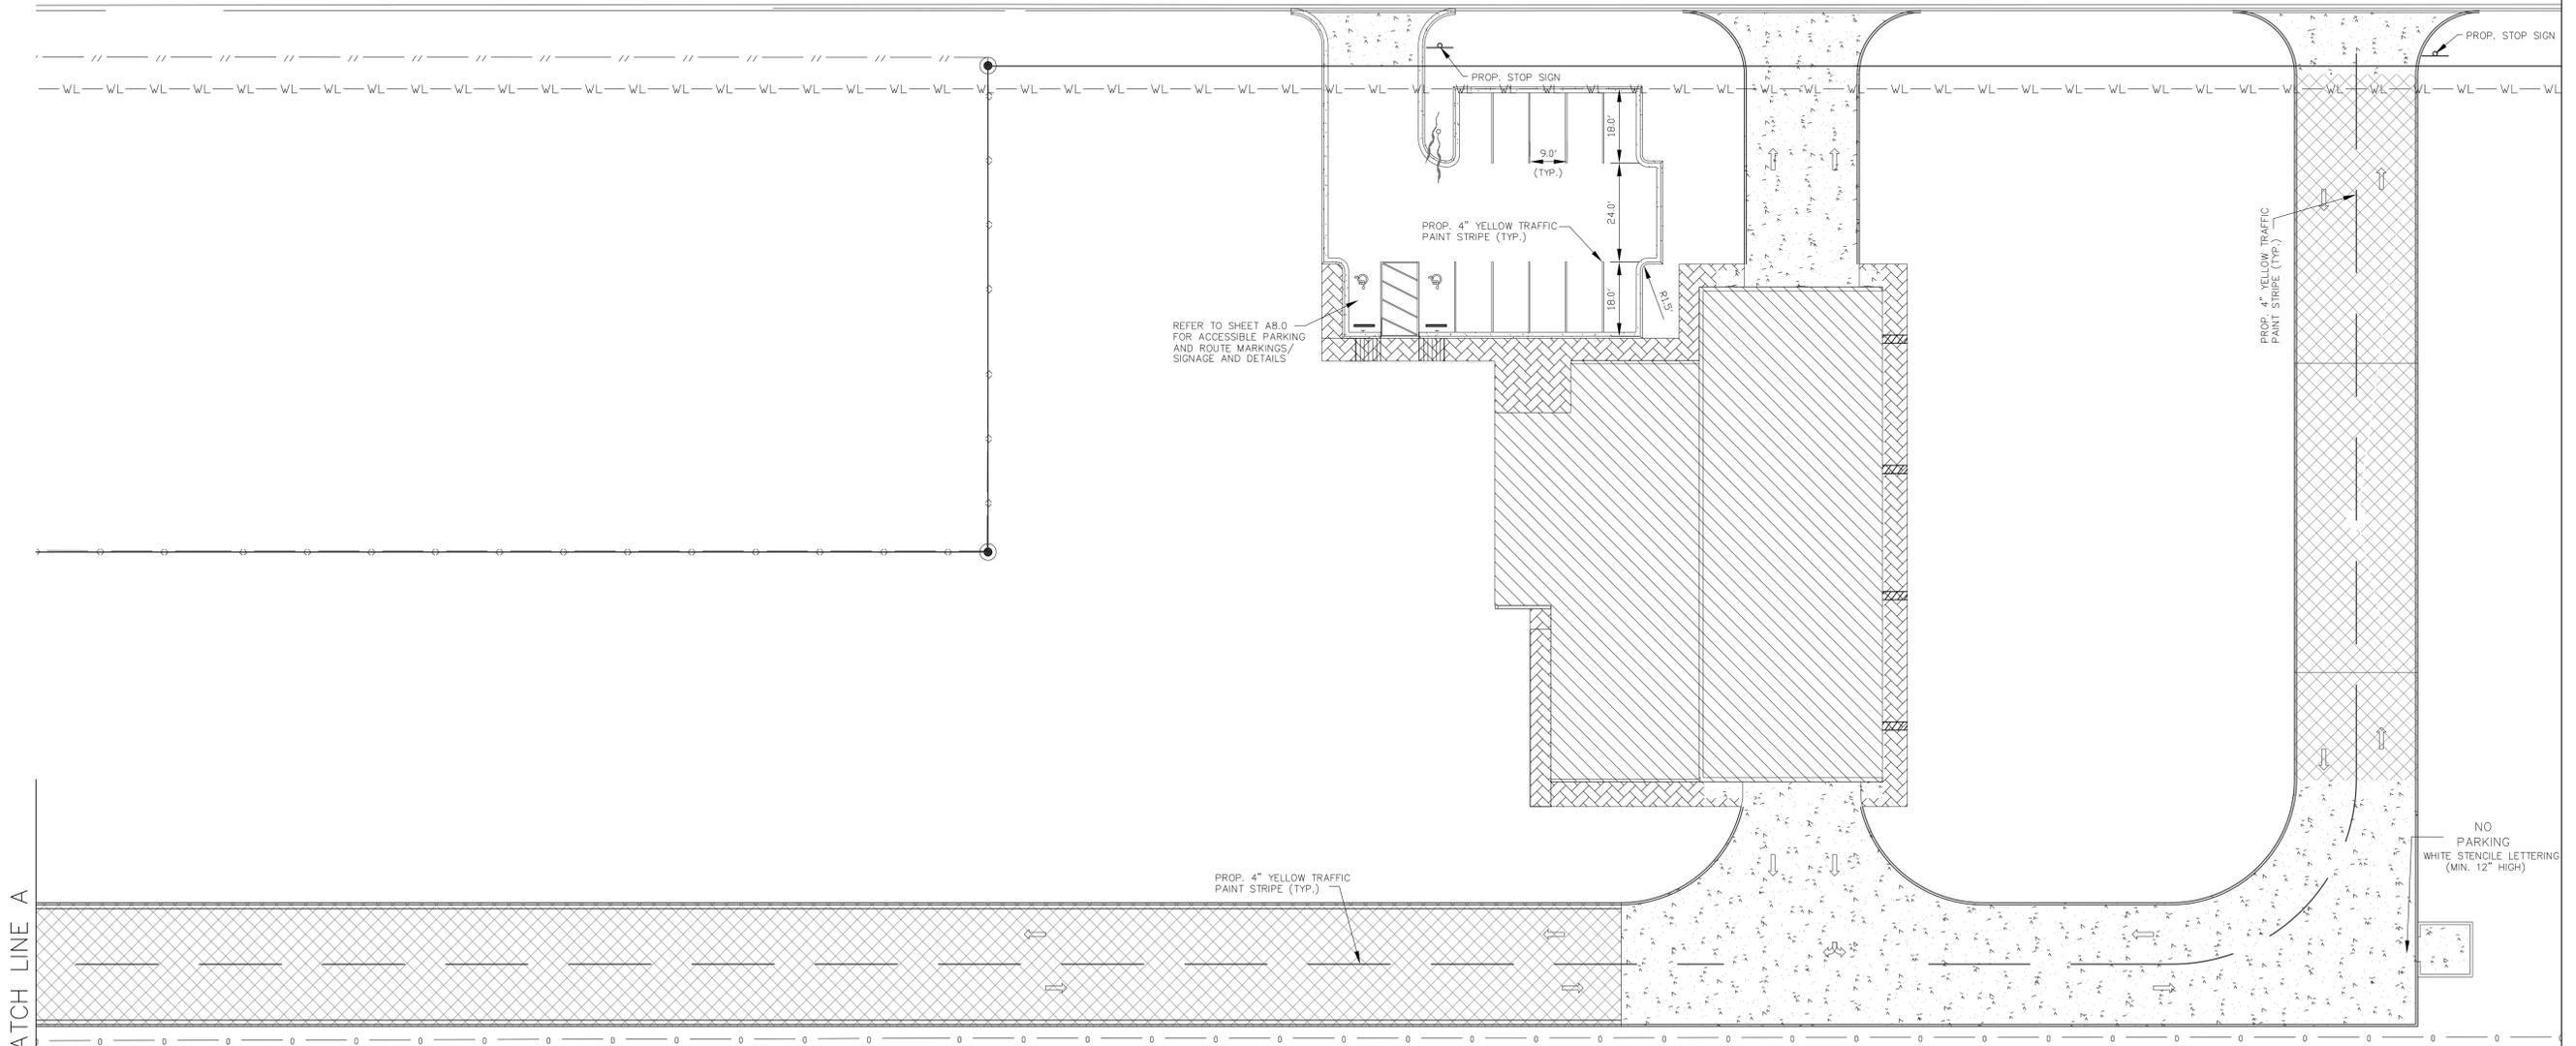

MATCH LINE A

MATCH LINE A

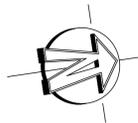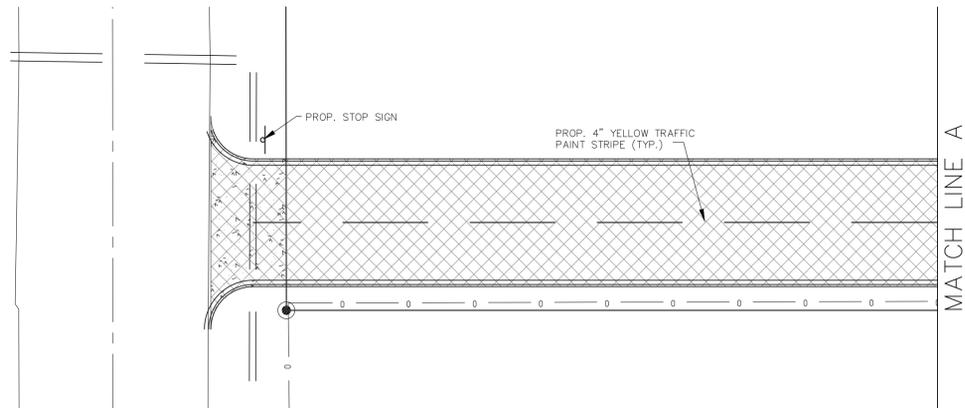

PROPOSED STRIPING
PLAN LAYOUT

SCALE: 1" = 20'



HINOJOSA ENGINEERING, INC.
 STRUCTURAL ENGINEERING
 CIVIL ENGINEERING • LAND SURVEYING
 108 W. 18TH ST. MISSION, TEXAS
 (956) 581-0143 FAX: (956) 581-2074
 E-MAIL: HinojosaEngInc@aol.com
 REGISTRATION NUMBER F-908 EXPIRATION DATE 9/30/2016



EDINBURG FIRE STATION # 5

CITY OF EDINBURG
JASMAN RD & FM 2812

PROJECT NUMBER
15-119
DATE
09-16-2015
ADDENDUM #1 1-07-16

SHEET
C3
OF



JASMAN ROAD

ALTERNATE #3

NEW BUILDING
14,501 SQ FT

MATCH LINE A

MATCH LINE A

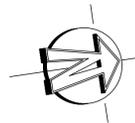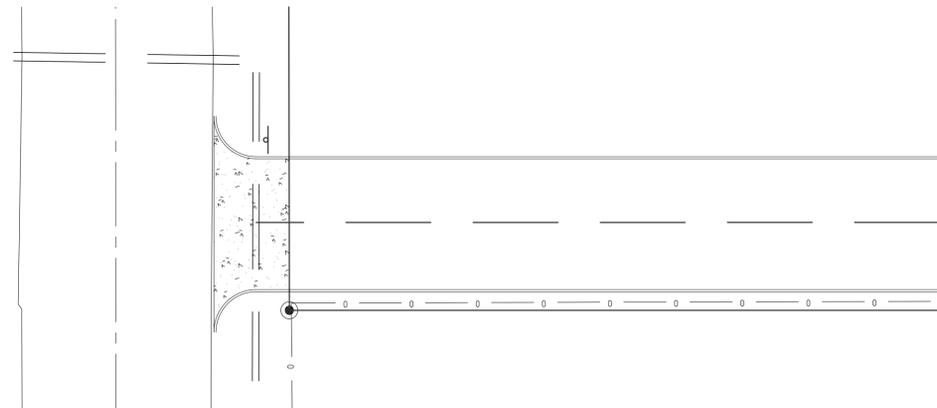

PROPOSED STRIPING PLAN
LAYOUT - ALTERNATES

SCALE: 1"=20'



HINOJOSA ENGINEERING, INC.
 STRUCTURAL ENGINEERING
 CIVIL ENGINEERING • LAND SURVEYING
 108 W. 18TH ST. MISSION, TEXAS
 (956) 581-0143 FAX: (956) 581-2074
 E-MAIL: HinojosaEngInc@aol.com
 REGISTRATION NUMBER F-908 EXPIRATION DATE 9/30/2016



Milnet
Architectural
Services

AMERICAN INSTITUTE OF ARCHITECTS

EDINBURG FIRE STATION # 5

CITY OF EDINBURG
JASMAN RD & FM 2812

PROJECT NUMBER
15-119

DATE
09-16-2015
ADDENDUM #1 1-07-16

SHEET

C3A

OF




Milnet
Architectural
Services

AMERICAN INSTITUTE OF ARCHITECTS

NOTE:
Contractor shall grade areas within 10' of the building at a minimum slope of 1:20 away from the building. Coordinate with Engineer if any areas are found which will not meet minimum slope.

NOTE:
Refer to Geotechnical Investigation Report for ground water and soil conditions and for recommendations. Contractor is to be familiar with information contained in Geotechnical Investigation Report prior to bid and construction.

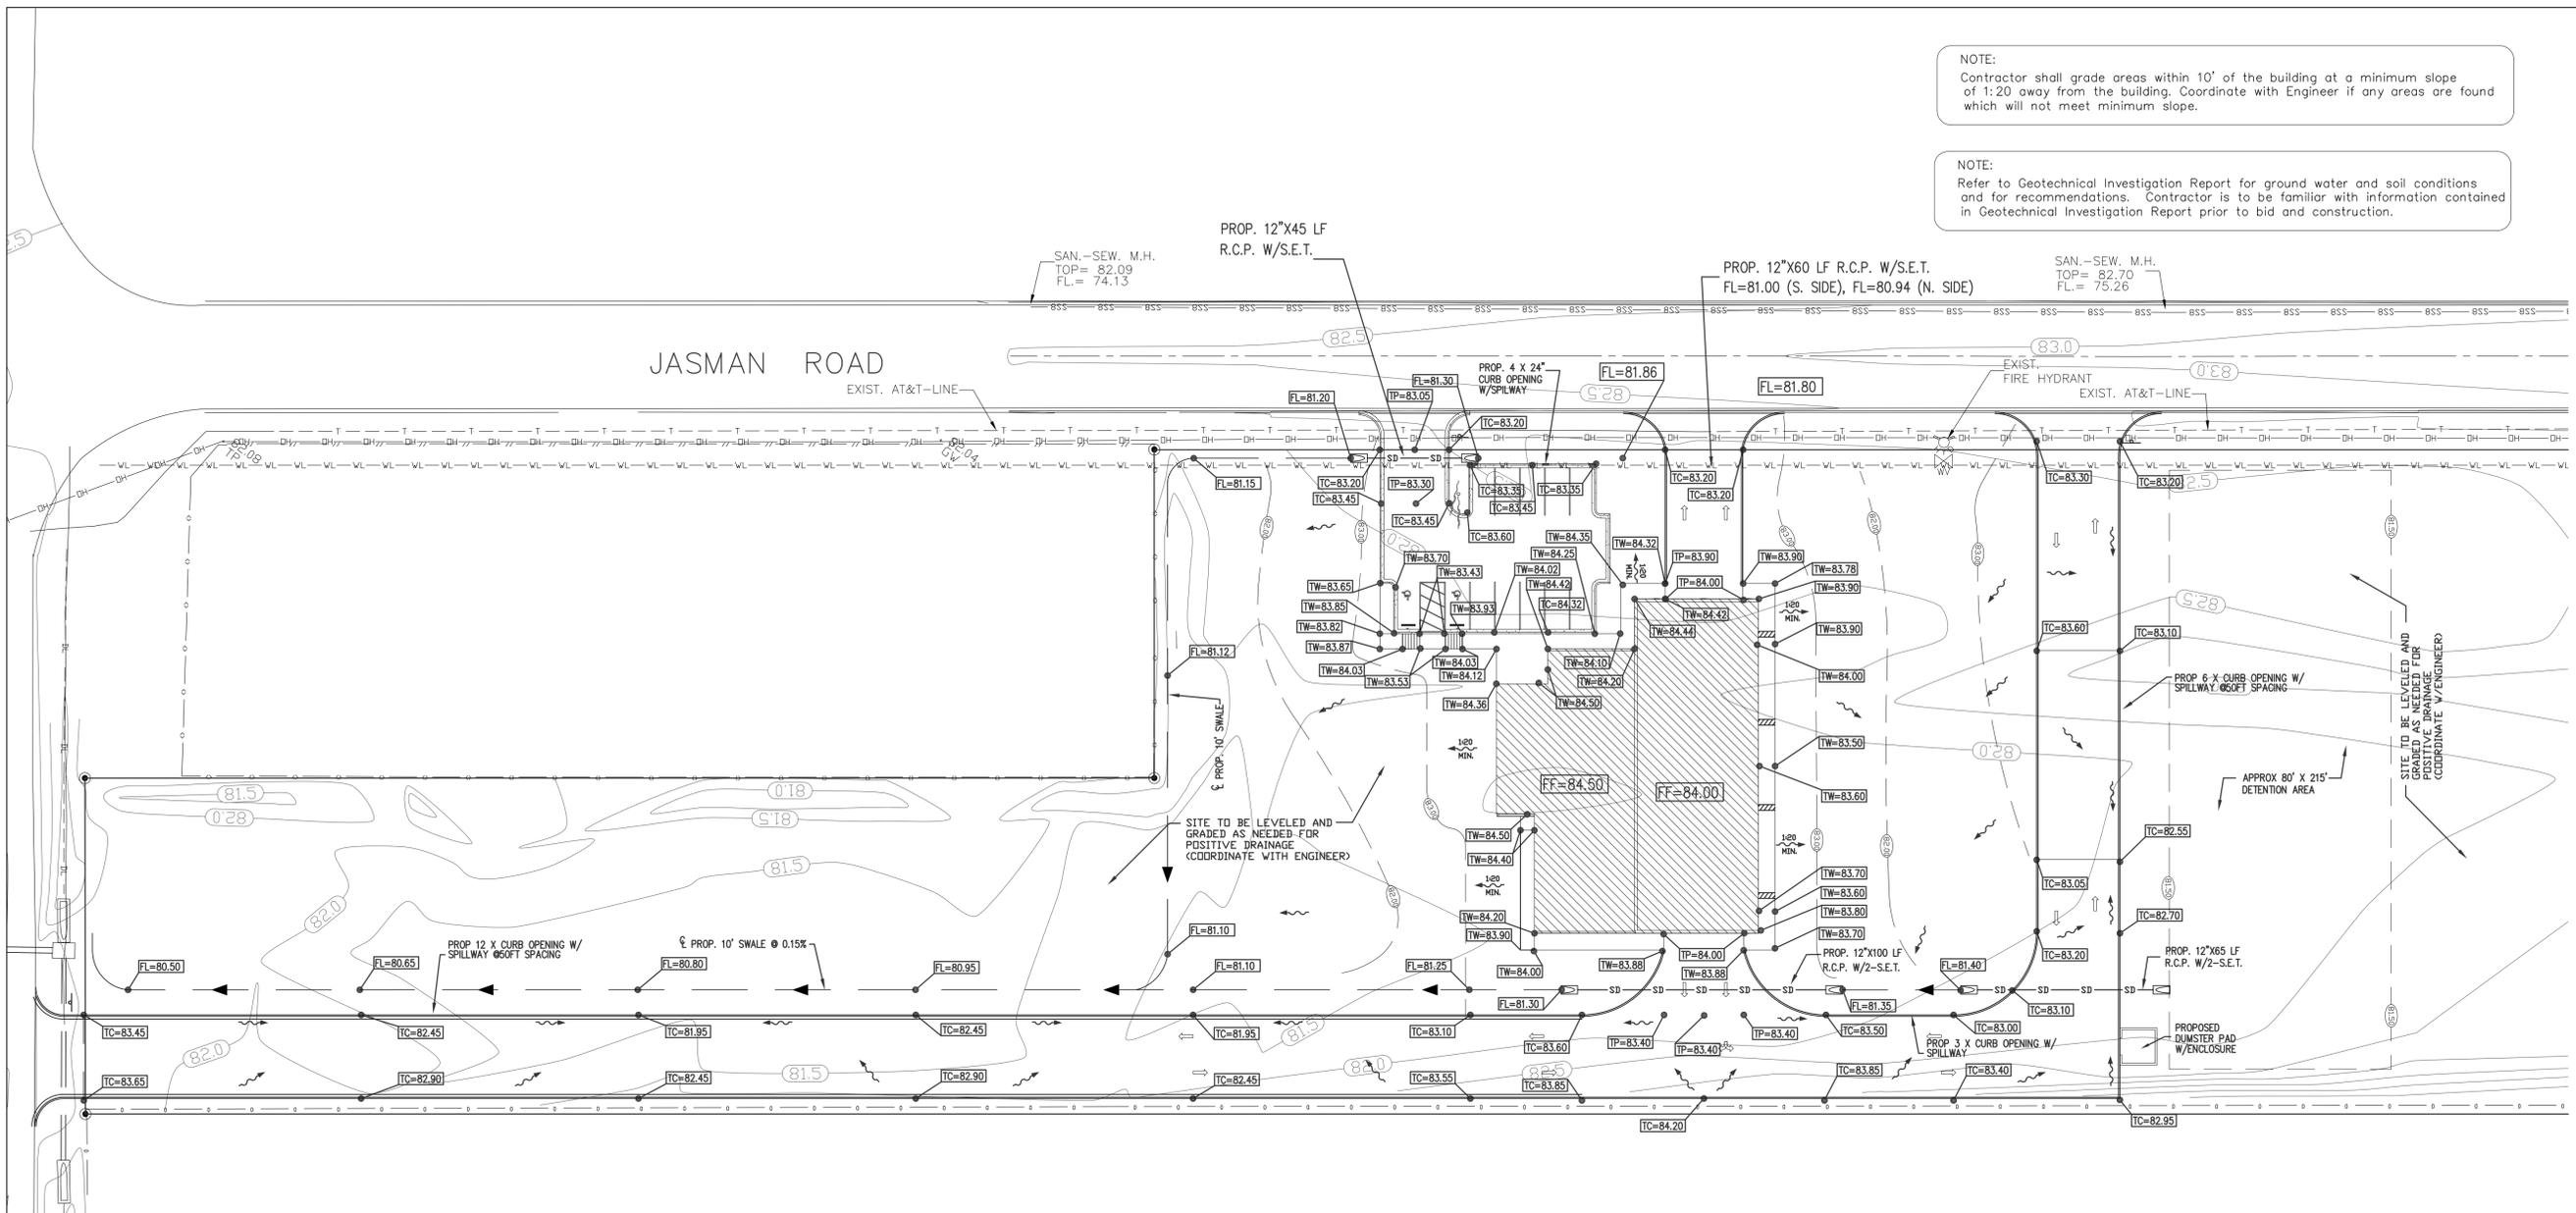

GENERAL NOTES:


- 1.) THE CONTRACTOR SHALL BE SOLELY RESPONSIBLE FOR COMPLYING WITH LOCAL, STATE AND FEDERAL LAWS AND OTHER SAFETY REGULATIONS THAT MAY GOVERN THE WORK OF THIS PROJECT.
- 2.) CONTRACTOR SHALL BE RESPONSIBLE FOR OBTAINING CONSTRUCTION PERMITS AS NEEDED FROM CITY AND/ OR OTHER LOCAL AUTHORITIES. CONTRACTOR SHALL PAY ALL PERMIT FEES ASSOCIATED WITH OBTAINING PERMITS.
- 3.) CONTRACTOR SHALL BE RESPONSIBLE FOR THE WELL BEING OF ALL MATERIALS USED IN THIS PROJECT UNTIL THE TIME OF ACCEPTANCE AND FINAL PAYMENT.
- 4.) IT SHALL BE THE RESPONSIBILITY OF THE CONTRACTOR TO PERFORM ALL WORK IN ACCORDANCE WITH THE CONTRACT DRAWINGS. NO ADDITIONS, DELETIONS OR MODIFICATIONS TO THE WORK SHALL BE MADE WITHOUT THE WRITTEN APPROVAL OF THE ENGINEER.
- 5.) CONTRACTOR SHALL VERIFY ALL DIMENSIONS ON THE GROUND. ANY DISCREPANCY BETWEEN CONTRACTOR'S MEASUREMENTS AND CONTRACT DOCUMENTS SHALL BE BROUGHT TO THE IMMEDIATE ATTENTION OF THE ENGINEER AND CONTRACTOR SHALL CEASE WORK UNTIL THE DISCREPANCY IS RESOLVED.
- 6.) CONTRACTOR SHALL HAND DIG WITHIN 5 FEET EITHER SIDE OF CROSSINGS UNTIL THE UTILITY IS PHYSICALLY EXPOSED PRIOR TO PERFORMING MECHANICAL TRENCHING OR EXCAVATION.
- 7.) EXISTING BURIED UTILITIES SHOWN IN THE CONTRACT DOCUMENTS WERE ESTABLISHED BY SEARCH OF RECORDS AND BY LOCATING GROUND INFORMATION. THESE UTILITIES ARE SHOWN FOR REFERENCE PURPOSES ONLY AND THE LOCATIONS OF SUCH MAY NOT BE EXACT, AND OTHER UTILITIES NOT SHOWN MAY EXIST. IT SHALL BE THE RESPONSIBILITY OF THE CONTRACTOR TO INFORM THE PROPER UTILITY AUTHORITIES OF ALL EXCAVATION WORK AND PHYSICALLY LOCATE AND PROTECT ALL UTILITIES DURING THE ENTIRE CONSTRUCTION PROCESS.
- 8.) IT SHALL BE THE CONTRACTOR'S RESPONSIBILITY TO TAKE ALL PRECAUTIONARY MEASURES AS NEEDED TO PROTECT ALL EXISTING FACILITIES, WHICH ARE NOT CALLED FOR IN THE CONTRACT DOCUMENTS TO BE REPAIRED, REPLACED OR OTHERWISE ALTERED, FROM DAMAGE. DAMAGE TO ANY EXISTING FACILITY THAT IS THE FAULT OF THE CONTRACTOR SHALL BE REPAIRED OR THE FACILITY SHALL BE REPLACED AS NEEDED TO RESTORE THE DAMAGED FACILITY TO ITS ORIGINAL CONDITION OR BETTER AT NO ADDITIONAL EXPENSE TO THE OWNER.
- 9.) CONTRACTOR SHALL RESTORE TO ITS ORIGINAL CONDITION OR BETTER, ALL SURFACE MEDIA SPECIFIED ON THE DRAWINGS FOR REPAIR OR ANY DAMAGED AREAS NOT SPECIFIED WHICH ARE DAMAGED BY THE CONTRACTOR'S OWN NEGLIGENCE.
- 10.) CONTRACTOR SHALL REVIEW GRADING PLAN BEFORE INSTALLATION OF UTILITY LINES FOR PROVIDING MINIMUM COVER AND ANTICIPATION OF CONFLICTS.
- 11.) CONTRACTOR SHALL BE RESPONSIBLE FOR CLEARING AND GRUBBING PROJECT LIMITS.
- 12.) COORDINATE WITH ENGINEER AND UTILITY PROVIDER BEFORE ANY EXCAVATION IS PERFORMED.
- 13.) CONTRACTOR SHALL GRADE ENTIRE SITE FOR POSITIVE DRAINAGE
- 14.) CONTRACTOR SHALL REGRADE AND/OR FILL BETWEEN BUILDING, CURBS, WALKS, DRAINAGE PONDS & PROJECT'S BOUNDARY.
- 15.) SYMBOLS SHOWN ARE NOT TO SCALE; REFER TO DETAILS FOR DIMENSIONS AND PLACEMENT OR COORDINATE WITH ENGINEER IF NOT SHOWN.
- 16.) REFER TO ARCHITECTURAL PLANS FOR JOINT LOCATIONS ON ALL CONCRETE WALKS AND PAVEMENTS.
- 17.) WATERLINE MUST BE INSTALLED BY A CITY OF EDINBURG APPROVED CONTRACTOR TO CITY OF EDINBURG SPECIFICATIONS.
- 18.) ALL EXPOSED VERTICAL CONCRETE SURFACES (SCREEN/RETAINING WALL) SHALL BE FREE OF HONEY COMBS AND DISCOLORATION. CONCRETE SHALL HAVE A SMOOTH SURFACE.
- 19.) CONTRACTOR TO BE FAMILIAR WITH ANY SPECIAL CONSTRUCTION REQUIREMENTS WHILE WORKING WITHIN THE CITY OF EDINBURG.
- 20.) CONTRACTOR SHALL INCLUDE IN HIS BID A TOTAL OF 3 ADDITIONAL CONFLICT MAN HOLES. ANY NOT UTILIZED DURING CONSTRUCTION SHALL BE CREDITED BACK TO THE OWNER AT THE END OF THE PROJECT CONSTRUCTION AT \$3,200 EACH.

LEGEND

	SIDEWALK TRENCH
	TOP OF CURB ELEVATION
	TOP OF WALK ELEVATION
	TOP OF PAVEMENT ELEVATION
	FLOWLINE ELEVATION
	FINISHED FLOOR ELEVATION
	PROPOSED CONTOUR ELEVATION

PROPOSED GRADING AND DRAINAGE PLAN LAYOUT

SCALE: 1" = 30'

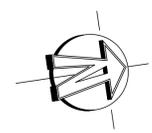

HINOJOSA ENGINEERING, INC.
 STRUCTURAL ENGINEERING
 CIVIL ENGINEERING • LAND SURVEYING
 108 W. 18TH ST. MISSION, TEXAS
 (956) 581-0143 FAX: (956) 581-2074
 E-MAIL: HinojosaEngin@aol.com
 REGISTRATION NUMBER F-908 EXPIRATION DATE 9/30/2016

EDINBURG FIRE STATION # 5
CITY OF EDINBURG
JASMAN RD & FM 2812

PROJECT NUMBER 15-119
DATE 09-16-2015
ADDENDUM #1 1-07-16

SHEET
C4
OF




Milnet
Architectural
Services
AMERICAN INSTITUTE OF ARCHITECTS

EDINBURG FIRE STATION # 5

CITY OF EDINBURG
JASMAN RD & FM 2812

PROJECT NUMBER
15-119
DATE
09-16-2015
ADDENDUM #1 1-07-16

SHEET
C4A
OF

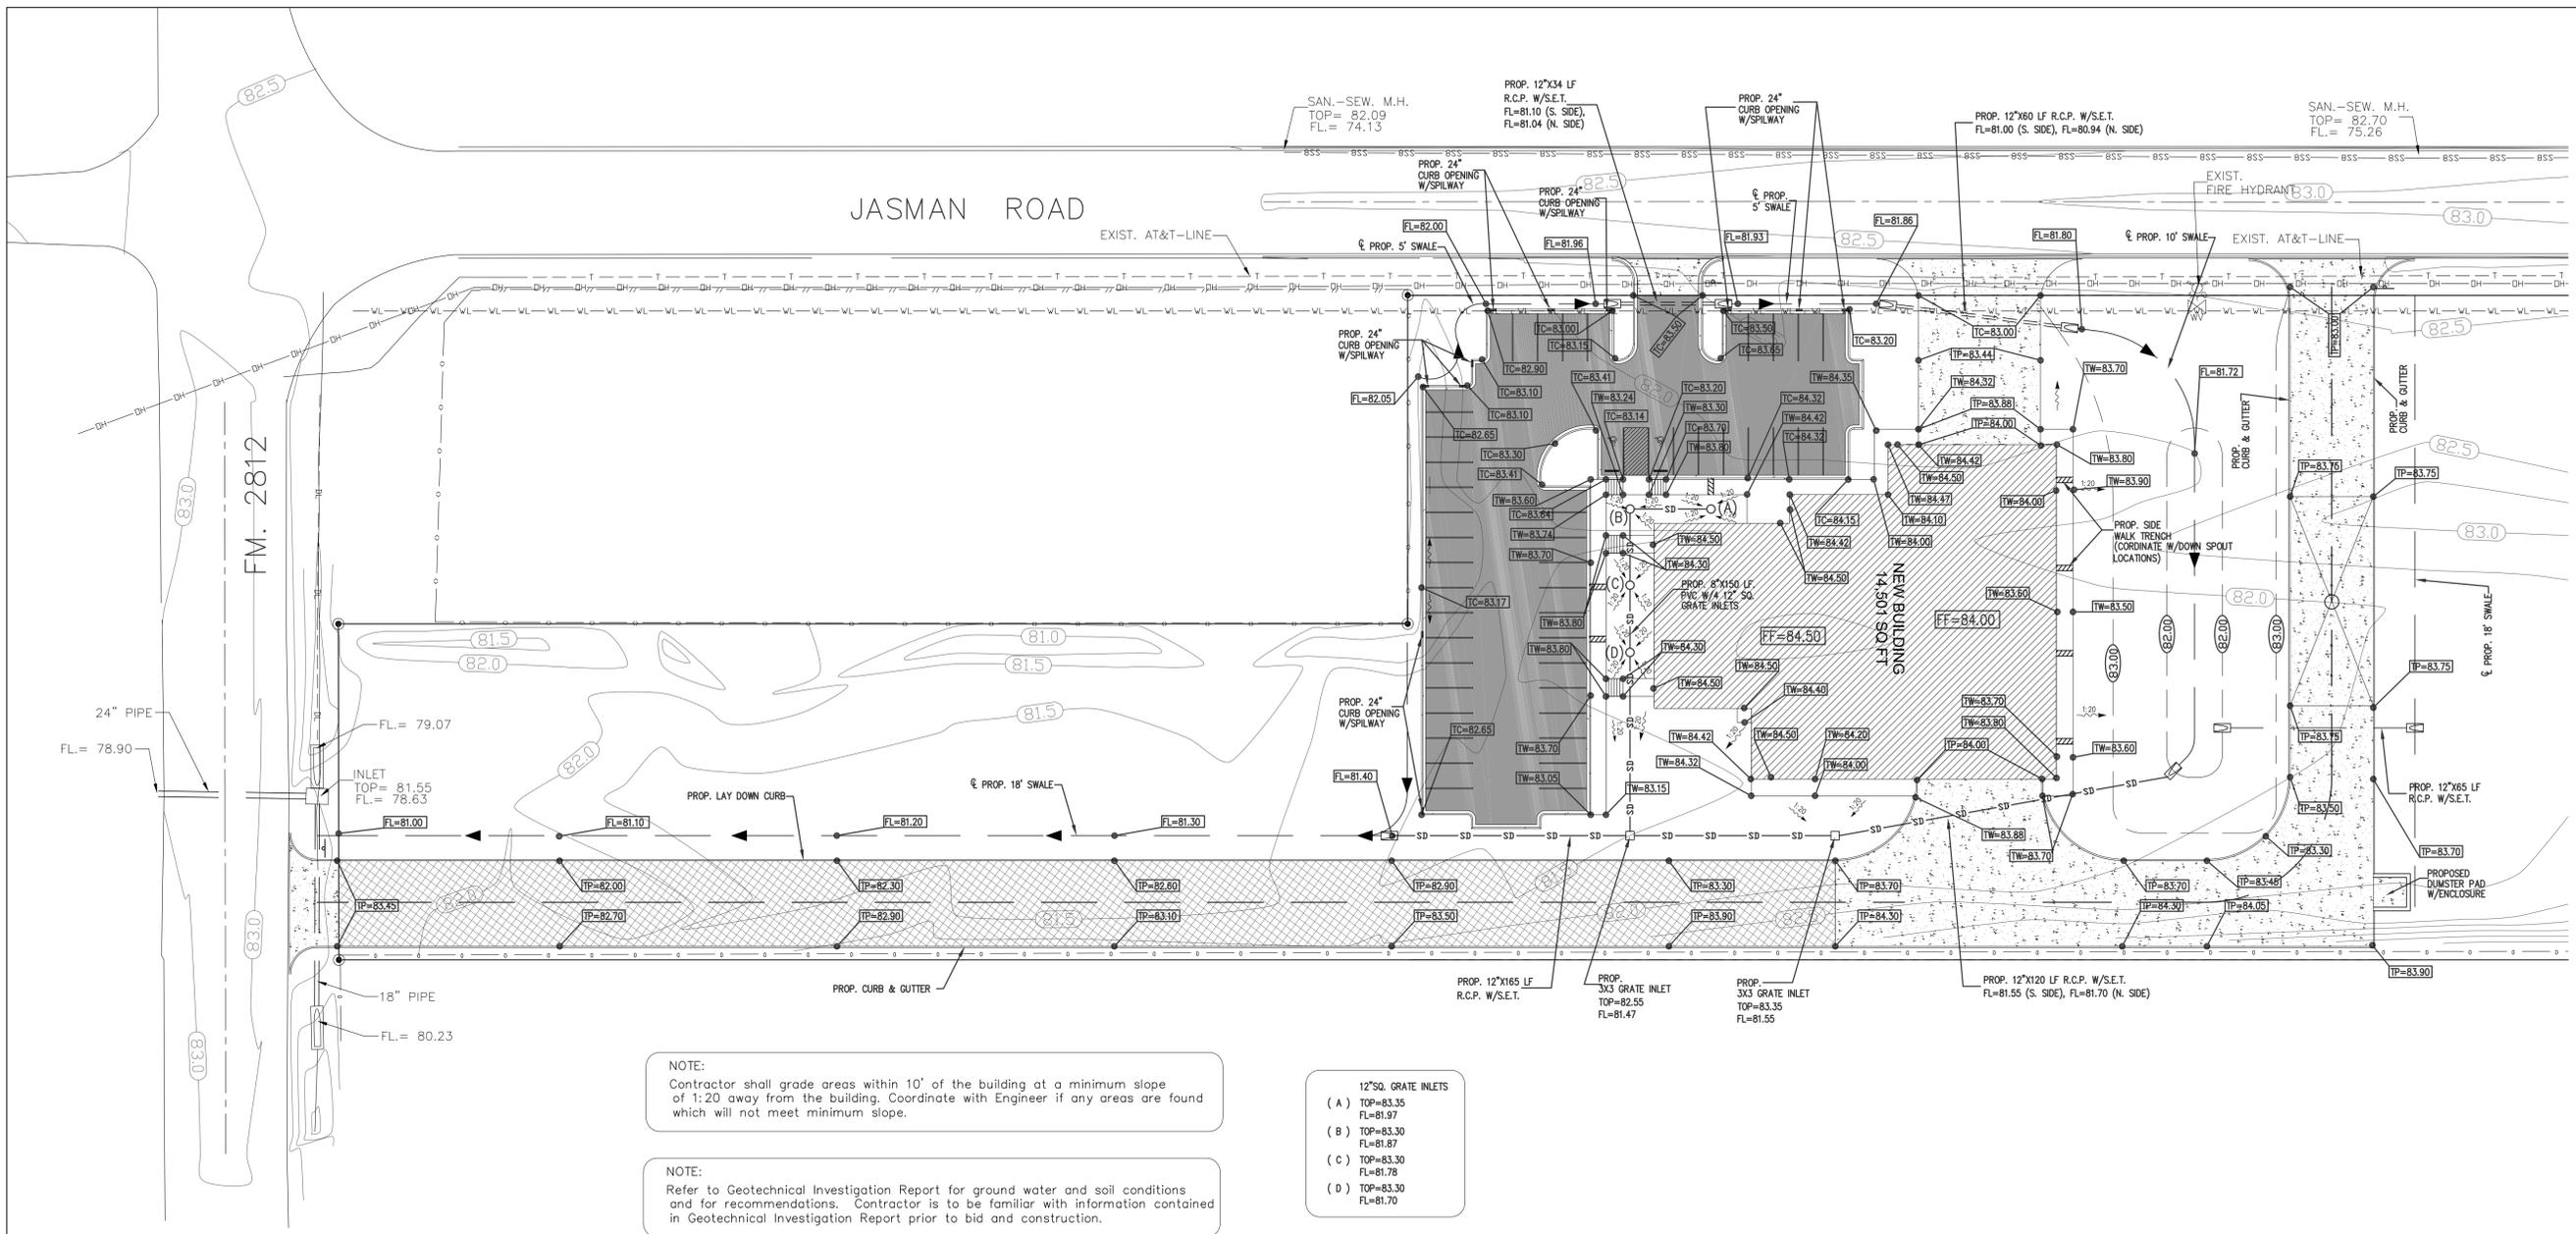


NOTE:
Contractor shall grade areas within 10' of the building at a minimum slope of 1:20 away from the building. Coordinate with Engineer if any areas are found which will not meet minimum slope.

NOTE:
Refer to Geotechnical Investigation Report for ground water and soil conditions and for recommendations. Contractor is to be familiar with information contained in Geotechnical Investigation Report prior to bid and construction.

12\"/>

(A)	TOP=83.35
	FL=81.97
(B)	TOP=83.30
	FL=81.87
(C)	TOP=83.30
	FL=81.78
(D)	TOP=83.30
	FL=81.70

- NOTES:
- THE CONTRACTOR SHALL BE SOLELY RESPONSIBLE FOR COMPLYING WITH LOCAL, STATE AND FEDERAL LAWS AND OTHER SAFETY REGULATIONS THAT MAY GOVERN THE WORK OF THIS PROJECT.
 - CONTRACTOR SHALL BE RESPONSIBLE FOR OBTAINING CONSTRUCTION PERMITS AS NEEDED FROM CITY AND/ OR OTHER LOCAL AUTHORITIES. CONTRACTOR SHALL PAY ALL PERMIT FEES ASSOCIATED WITH OBTAINING PERMITS.
 - CONTRACTOR SHALL BE RESPONSIBLE FOR THE WELL BEING OF ALL MATERIALS USED IN THIS PROJECT UNTIL THE TIME OF ACCEPTANCE AND FINAL PAYMENT.
 - IT SHALL BE THE RESPONSIBILITY OF THE CONTRACTOR TO PERFORM ALL WORK IN ACCORDANCE WITH THE CONTRACT DRAWINGS. NO ADDITIONS, DELETIONS OR MODIFICATIONS TO THE WORK SHALL BE MADE WITHOUT THE WRITTEN APPROVAL OF THE ENGINEER.
 - CONTRACTOR SHALL VERIFY ALL DIMENSIONS ON THE GROUND. ANY DISCREPANCY BETWEEN CONTRACTOR'S MEASUREMENTS AND CONTRACT DOCUMENTS SHALL BE BROUGHT TO THE IMMEDIATE ATTENTION OF THE ENGINEER AND CONTRACTOR SHALL CEASE WORK UNTIL THE DISCREPANCY IS RESOLVED.
 - CONTRACTOR SHALL HAND DIG WITHIN 5 FEET EITHER SIDE OF CROSSINGS UNTIL THE UTILITY IS PHYSICALLY EXPOSED PRIOR TO PERFORMING MECHANICAL TRENCHING OR EXCAVATION.
 - EXISTING BURIED UTILITIES SHOWN IN THE CONTRACT DOCUMENTS WERE ESTABLISHED BY SEARCH OF RECORDS AND BY LOCATING GROUND INFORMATION. THESE UTILITIES ARE SHOWN FOR REFERENCE PURPOSES ONLY AND THE LOCATIONS OF SUCH MAY NOT BE EXACT, AND OTHER UTILITIES NOT SHOWN MAY EXIST. IT SHALL BE THE RESPONSIBILITY OF THE CONTRACTOR TO INFORM THE PROPER UTILITY AUTHORITIES OF ALL EXCAVATION WORK AND PHYSICALLY LOCATE AND PROTECT ALL UTILITIES DURING THE ENTIRE CONSTRUCTION PROCESS.
 - IT SHALL BE THE CONTRACTOR'S RESPONSIBILITY TO TAKE ALL PRECAUTIONARY MEASURES AS NEEDED TO PROTECT ALL EXISTING FACILITIES, WHICH ARE NOT CALLED FOR IN THE CONTRACT DOCUMENTS TO BE REPAIRED, REPLACED OR OTHERWISE ALTERED, FROM DAMAGE. DAMAGE TO ANY EXISTING FACILITY THAT IS THE FAULT OF THE CONTRACTOR SHALL BE REPAIRED OR THE FACILITY SHALL BE REPLACED AS NEEDED TO RESTORE THE DAMAGED FACILITY TO ITS ORIGINAL CONDITION OR BETTER AT NO ADDITIONAL EXPENSE TO THE OWNER.
 - CONTRACTOR SHALL RESTORE TO ITS ORIGINAL CONDITION OR BETTER, ALL SURFACE MEDIA SPECIFIED ON THE DRAWINGS FOR REPAIR OR ANY DAMAGED AREAS NOT SPECIFIED WHICH ARE DAMAGED BY THE CONTRACTOR'S OWN NEGLIGENCE.
 - CONTRACTOR SHALL REVIEW GRADING PLAN BEFORE INSTALLATION OF UTILITY LINES FOR PROVIDING MINIMUM COVER AND ANTICIPATION OF CONFLICTS.
 - CONTRACTOR SHALL BE RESPONSIBLE FOR CLEARING AND GRUBBING PROJECT LIMITS.
 - COORDINATE WITH ENGINEER AND UTILITY PROVIDER BEFORE ANY EXCAVATION IS PERFORMED.
 - CONTRACTOR SHALL GRADE ENTIRE SITE FOR POSITIVE DRAINAGE
 - CONTRACTOR SHALL REGRADE AND/OR FILL BETWEEN BUILDING, CURBS, WALKS, DRAINAGE PONDS & PROJECT'S BOUNDARY.
 - SYMBOLS SHOWN ARE NOT TO SCALE; REFER TO DETAILS FOR DIMENSIONS AND PLACEMENT OR COORDINATE WITH ENGINEER IF NOT SHOWN.
 - REFER TO ARCHITECTURAL PLANS FOR JOINT LOCATIONS ON ALL CONCRETE WALKS AND PAVEMENTS.
 - WATERLINE MUST BE INSTALLED BY AN CITY OF EDINBURG APPROVED CONTRACTOR TO CITY OF EDINBURG SPECIFICATIONS.
 - ALL EXPOSED VERTICAL CONCRETE SURFACES (SCREEN/RETAINING WALL) SHALL BE FREE OF HONEY COMBS AND DISCOLORATION. CONCRETE SHALL HAVE A SMOOTH SURFACE.
 - CONTRACTOR TO BE FAMILIAR WITH ANY SPECIAL CONSTRUCTION REQUIREMENTS WHILE WORKING WITHIN THE CITY OF EDINBURG.
 - CONTRACTOR SHALL INCLUDE IN HIS BID A TOTAL OF 3 ADDITIONAL CONFLICT MAN HOLES. ANY NOT UTILIZED DURING CONSTRUCTION SHALL BE CREDITED BACK TO THE OWNER AT THE END OF THE PROJECT CONSTRUCTION AT \$3,200 EACH..

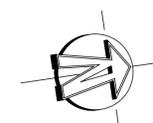

**PROPOSED GRADING AND DRAINAGE
PLAN LAYOUT - ALTERNATE #3**

SCALE: 1"=30'



HINOJOSA ENGINEERING, INC.
STRUCTURAL ENGINEERING
CIVIL ENGINEERING-LAND SURVEYING
108 W. 18TH ST. MISSION, TEXAS
(956) 581-0143 FAX: (956) 581-2074
E-MAIL: HinojosaEnginc@aol.com
REGISTRATION NUMBER F-908 EXPIRATION DATE 9/30/2016



Milnet
Architectural
Services
AMERICAN INSTITUTE OF ARCHITECTS


EDINBURG FIRE STATION # 5

CITY OF EDINBURG
JASMAN RD & FM 2812

PROJECT NUMBER
15-119
DATE
09-16-2015
ADDENDUM #1 1-07-16

SHEET
C5
OF

NOTE:
Refer to Geotechnical Investigation Report for ground water and soil conditions and for recommendations. Contractor is to be familiar with information contained in Geotechnical Investigation Report prior to bid and construction.

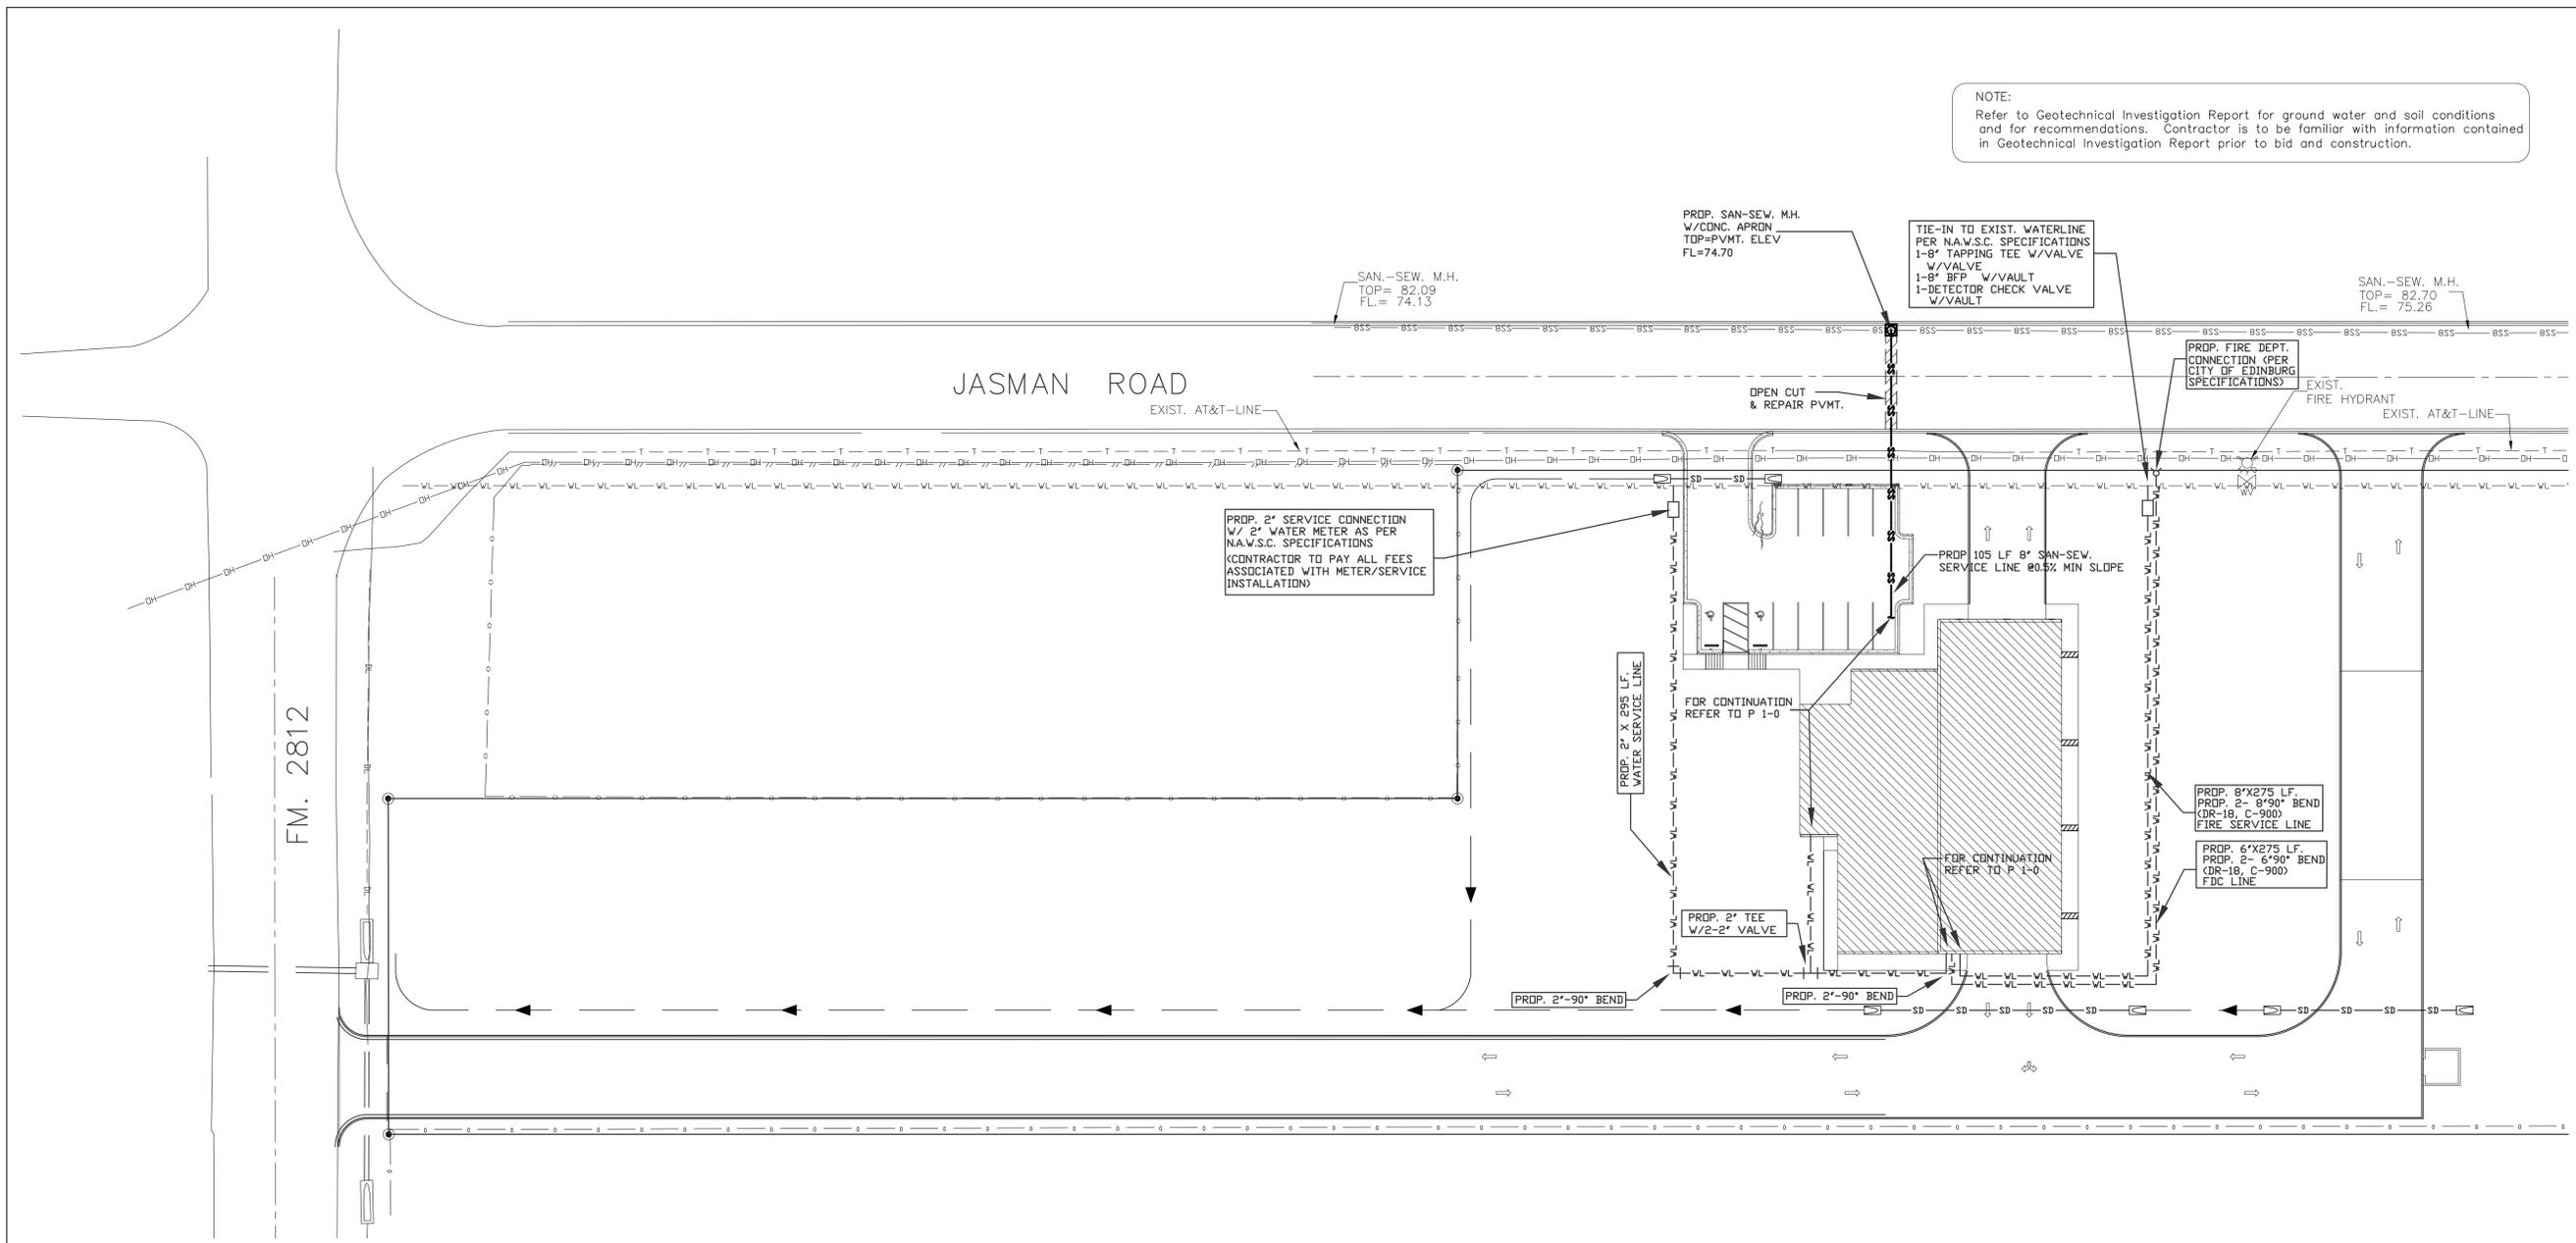


GENERAL NOTES:

- 1.) THE CONTRACTOR SHALL BE SOLELY RESPONSIBLE FOR COMPLYING WITH LOCAL, STATE AND FEDERAL LAWS AND OTHER SAFETY REGULATIONS THAT MAY GOVERN THE WORK OF THIS PROJECT.
- 2.) CONTRACTOR SHALL BE RESPONSIBLE FOR OBTAINING CONSTRUCTION PERMITS AS NEEDED FROM CITY AND/ OR OTHER LOCAL AUTHORITIES. CONTRACTOR SHALL PAY ALL PERMIT FEES ASSOCIATED WITH OBTAINING PERMITS.
- 3.) CONTRACTOR SHALL BE RESPONSIBLE FOR THE WELL BEING OF ALL MATERIALS USED IN THIS PROJECT UNTIL THE TIME OF ACCEPTANCE AND FINAL PAYMENT.
- 4.) IT SHALL BE THE RESPONSIBILITY OF THE CONTRACTOR TO PERFORM ALL WORK IN ACCORDANCE WITH THE CONTRACT DRAWINGS. NO ADDITIONS, DELETIONS OR MODIFICATIONS TO THE WORK SHALL BE MADE WITHOUT THE WRITTEN APPROVAL OF THE ENGINEER.
- 5.) CONTRACTOR SHALL VERIFY ALL DIMENSIONS ON THE GROUND. ANY DISCREPANCY BETWEEN CONTRACTOR'S MEASUREMENTS AND CONTRACT DOCUMENTS SHALL BE BROUGHT TO THE IMMEDIATE ATTENTION OF THE ENGINEER AND CONTRACTOR SHALL CEASE WORK UNTIL THE DISCREPANCY IS RESOLVED.
- 6.) CONTRACTOR SHALL HAND DIG WITHIN 5 FEET EITHER SIDE OF CROSSINGS UNTIL THE UTILITY IS PHYSICALLY EXPOSED PRIOR TO PERFORMING MECHANICAL TRENCHING OR EXCAVATION.
- 7.) EXISTING BURIED UTILITIES SHOWN IN THE CONTRACT DOCUMENTS WERE ESTABLISHED BY SEARCH OF RECORDS AND BY LOCATING GROUND INFORMATION. THESE UTILITIES ARE SHOWN FOR REFERENCE PURPOSES ONLY AND THE LOCATIONS OF SUCH MAY NOT BE EXACT, AND OTHER UTILITIES NOT SHOWN MAY EXIST. IT SHALL BE THE RESPONSIBILITY OF THE CONTRACTOR TO INFORM THE PROPER UTILITY AUTHORITIES OF ALL EXCAVATION WORK AND PHYSICALLY LOCATE AND PROTECT ALL UTILITIES DURING THE ENTIRE CONSTRUCTION PROCESS.
- 8.) IT SHALL BE THE CONTRACTOR'S RESPONSIBILITY TO TAKE ALL PRECAUTIONARY MEASURES AS NEEDED TO PROTECT ALL EXISTING FACILITIES, WHICH ARE NOT CALLED FOR IN THE CONTRACT DOCUMENTS TO BE REPAIRED, REPLACED OR OTHERWISE ALTERED, FROM DAMAGE. DAMAGE TO ANY EXISTING FACILITY THAT IS THE FAULT OF THE CONTRACTOR SHALL BE REPAIRED OR THE FACILITY SHALL BE REPLACED AS NEEDED TO RESTORE THE DAMAGED FACILITY TO ITS ORIGINAL CONDITION OR BETTER AT NO ADDITIONAL EXPENSE TO THE OWNER.
- 9.) CONTRACTOR SHALL RESTORE TO ITS ORIGINAL CONDITION OR BETTER, ALL SURFACE MEDIA SPECIFIED ON THE DRAWINGS FOR REPAIR OR ANY DAMAGED AREAS NOT SPECIFIED WHICH ARE DAMAGED BY THE CONTRACTOR'S OWN NEGLIGENCE.
- 10.) CONTRACTOR SHALL REVIEW GRADING PLAN BEFORE INSTALLATION OF UTILITY LINES FOR PROVIDING MINIMUM COVER AND ANTICIPATION OF CONFLICTS.
- 11.) CONTRACTOR SHALL BE RESPONSIBLE FOR CLEARING AND GRUBBING PROJECT LIMITS.
- 12.) COORDINATE WITH ENGINEER AND UTILITY PROVIDER BEFORE ANY EXCAVATION IS PERFORMED.
- 13.) CONTRACTOR SHALL GRADE ENTIRE SITE FOR POSITIVE DRAINAGE
- 14.) CONTRACTOR SHALL REGRADE AND/OR FILL BETWEEN BUILDING, CURBS, WALKS, DRAINAGE PONDS & PROJECT'S BOUNDARY.
- 15.) SYMBOLS SHOWN ARE NOT TO SCALE; REFER TO DETAILS FOR DIMENSIONS AND PLACEMENT OR COORDINATE WITH ENGINEER IF NOT SHOWN.
- 16.) REFER TO ARCHITECTURAL PLANS FOR JOINT LOCATIONS ON ALL CONCRETE WALKS AND PAVEMENTS.
- 17.) WATERLINE MUST BE INSTALLED BY A CITY OF EDINBURG APPROVED CONTRACTOR TO CITY OF EDINBURG SPECIFICATIONS.
- 18.) ALL EXPOSED VERTICAL CONCRETE SURFACES (SCREEN/RETAINING WALL) SHALL BE FREE OF HONEY COMBS AND DISCOLORATION. CONCRETE SHALL HAVE A SMOOTH SURFACE.
- 19.) CONTRACTOR TO BE FAMILIAR WITH ANY SPECIAL CONSTRUCTION REQUIREMENTS WHILE WORKING WITHIN THE CITY OF EDINBURG.
- 20.) CONTRACTOR SHALL INCLUDE IN HIS BID A TOTAL OF 3 ADDITIONAL CONFLICT MAN HOLES. ANY NOT UTILIZED DURING CONSTRUCTION SHALL BE CREDITED BACK TO THE OWNER AT THE END OF THE PROJECT CONSTRUCTION AT \$3,200 EACH.

WARNING
CONTRACTOR TO FIELD
VERIFY DEPTH & LOCATION
OF EXIST. UTILITIES PRIOR
TO CONSTRUCTION

**PROPOSED UTILITY
PLAN LAYOUT**
SCALE: 1"=30'

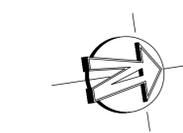


**HINOJOSA
ENGINEERING, INC.**
STRUCTURAL ENGINEERING
CIVIL ENGINEERING • LAND SURVEYING
108 W. 18TH ST. MISSION, TEXAS
(956) 581-0143 FAX: (956) 581-2074
E-MAIL: HinojosaEngInc@aol.com
REGISTRATION NUMBER F-908 EXPIRATION DATE 9/30/2016




Milnet
Architectural
Services
AMERICAN INSTITUTE OF ARCHITECTS

NOTE:
Refer to Geotechnical Investigation Report for ground water and soil conditions and for recommendations. Contractor is to be familiar with information contained in Geotechnical Investigation Report prior to bid and construction.

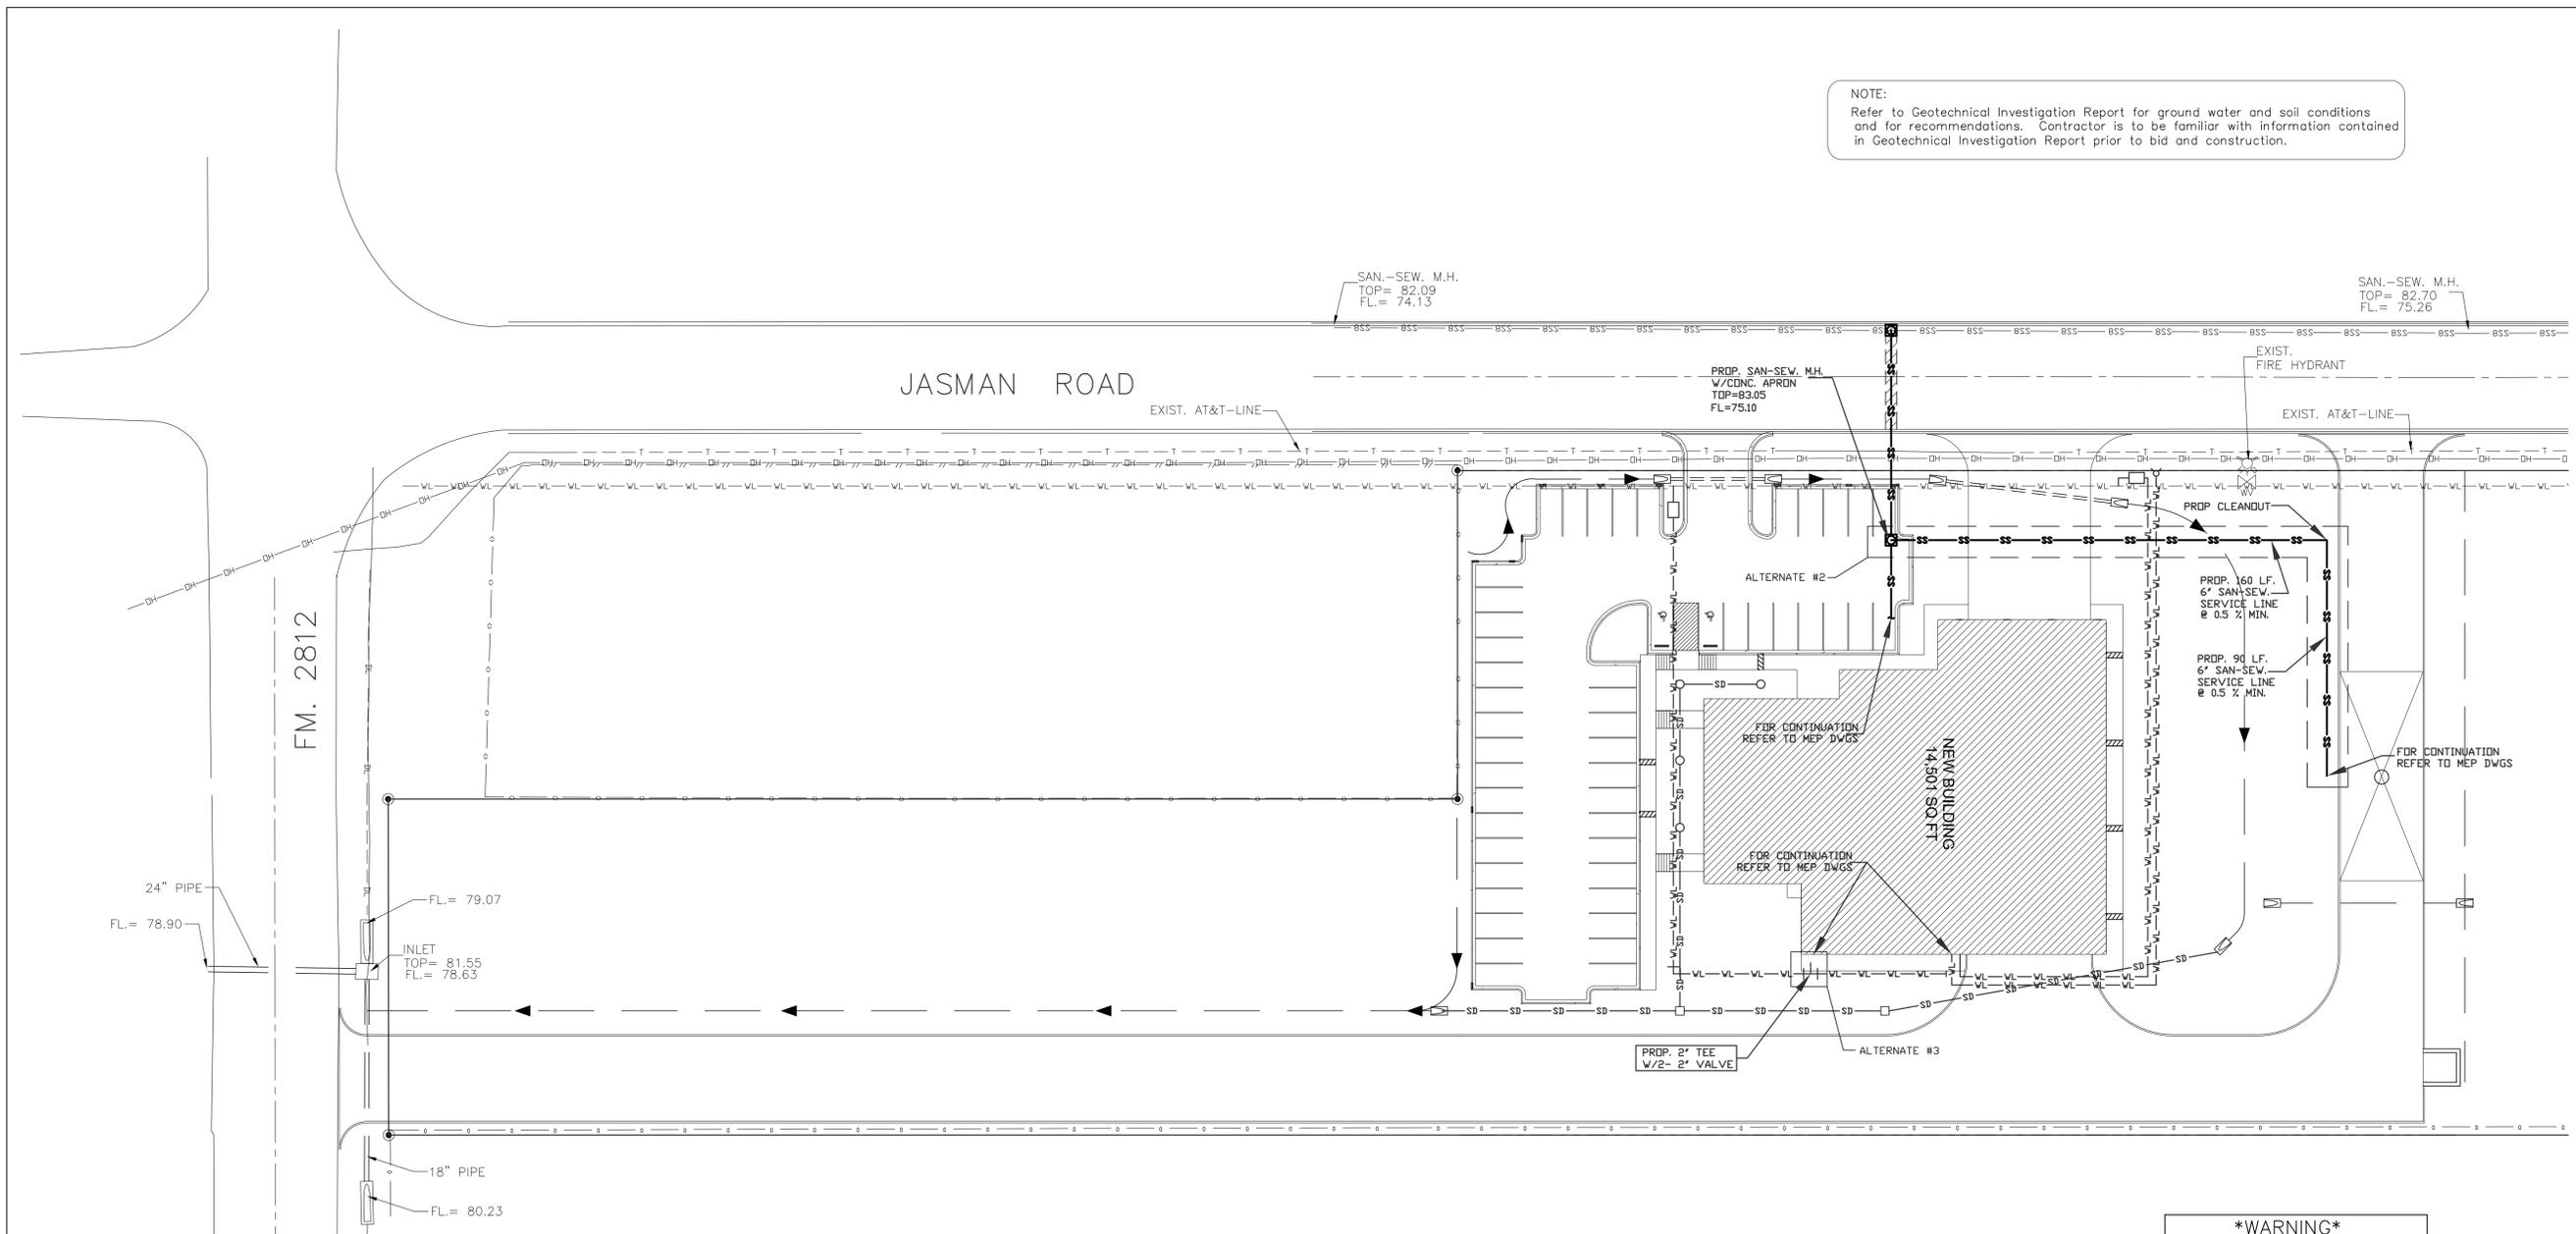

WARNING
CONTRACTOR TO FIELD
VERIFY DEPTH & LOCATION
OF EXIST. UTILITIES PRIOR
TO CONSTRUCTION

- NOTES:
- 1.) THE CONTRACTOR SHALL BE SOLELY RESPONSIBLE FOR COMPLYING WITH LOCAL, STATE AND FEDERAL LAWS AND OTHER SAFETY REGULATIONS THAT MAY GOVERN THE WORK OF THIS PROJECT.
 - 2.) CONTRACTOR SHALL BE RESPONSIBLE FOR OBTAINING CONSTRUCTION PERMITS AS NEEDED FROM CITY AND/ OR OTHER LOCAL AUTHORITIES. CONTRACTOR SHALL PAY ALL PERMIT FEES ASSOCIATED WITH OBTAINING PERMITS.
 - 3.) CONTRACTOR SHALL BE RESPONSIBLE FOR THE WELL BEING OF ALL MATERIALS USED IN THIS PROJECT UNTIL THE TIME OF ACCEPTANCE AND FINAL PAYMENT.
 - 4.) IT SHALL BE THE RESPONSIBILITY OF THE CONTRACTOR TO PERFORM ALL WORK IN ACCORDANCE WITH THE CONTRACT DRAWINGS. NO ADDITIONS, DELETIONS OR MODIFICATIONS TO THE WORK SHALL BE MADE WITHOUT THE WRITTEN APPROVAL OF THE ENGINEER.
 - 5.) CONTRACTOR SHALL VERIFY ALL DIMENSIONS ON THE GROUND. ANY DISCREPANCY BETWEEN CONTRACTOR'S MEASUREMENTS AND CONTRACT DOCUMENTS SHALL BE BROUGHT TO THE IMMEDIATE ATTENTION OF THE ENGINEER AND CONTRACTOR SHALL CEASE WORK UNTIL THE DISCREPANCY IS RESOLVED.
 - 6.) CONTRACTOR SHALL HAND DIG WITHIN 5 FEET EITHER SIDE OF CROSSINGS UNTIL THE UTILITY IS PHYSICALLY EXPOSED PRIOR TO PERFORMING MECHANICAL TRENCHING OR EXCAVATION.
 - 7.) EXISTING BURIED UTILITIES SHOWN IN THE CONTRACT DOCUMENTS WERE ESTABLISHED BY SEARCH OF RECORDS AND BY LOCATING GROUND INFORMATION. THESE UTILITIES ARE SHOWN FOR REFERENCE PURPOSES ONLY AND THE LOCATIONS OF SUCH MAY NOT BE EXACT, AND OTHER UTILITIES NOT SHOWN MAY EXIST. IT SHALL BE THE RESPONSIBILITY OF THE CONTRACTOR TO INFORM THE PROPER UTILITY AUTHORITIES OF ALL EXCAVATION WORK AND PHYSICALLY LOCATE AND PROTECT ALL UTILITIES DURING THE ENTIRE CONSTRUCTION PROCESS.
 - 8.) IT SHALL BE THE CONTRACTOR'S RESPONSIBILITY TO TAKE ALL PRECAUTIONARY MEASURES AS NEEDED TO PROTECT ALL EXISTING FACILITIES, WHICH ARE NOT CALLED FOR IN THE CONTRACT DOCUMENTS TO BE REPAIRED, REPLACED OR OTHERWISE ALTERED, FROM DAMAGE. DAMAGE TO ANY EXISTING FACILITY THAT IS THE FAULT OF THE CONTRACTOR SHALL BE REPAIRED OR THE FACILITY SHALL BE REPLACED AS NEEDED TO RESTORE THE DAMAGED FACILITY TO ITS ORIGINAL CONDITION OR BETTER AT NO ADDITIONAL EXPENSE TO THE OWNER.
 - 9.) CONTRACTOR SHALL RESTORE TO ITS ORIGINAL CONDITION OR BETTER, ALL SURFACE MEDIA SPECIFIED ON THE DRAWINGS FOR REPAIR OR ANY DAMAGED AREAS NOT SPECIFIED WHICH ARE DAMAGED BY THE CONTRACTOR'S OWN NEGLIGENCE.
 - 10.) CONTRACTOR SHALL REVIEW GRADING PLAN BEFORE INSTALLATION OF UTILITY LINES FOR PROVIDING MINIMUM COVER AND ANTICIPATION OF CONFLICTS.
 - 11.) CONTRACTOR SHALL BE RESPONSIBLE FOR CLEARING AND GRUBBING PROJECT LIMITS.
 - 12.) COORDINATE WITH ENGINEER AND UTILITY PROVIDER BEFORE ANY EXCAVATION IS PERFORMED.
 - 13.) CONTRACTOR SHALL GRADE ENTIRE SITE FOR POSITIVE DRAINAGE
 - 14.) CONTRACTOR SHALL REGRADE AND/OR FILL BETWEEN BUILDING, CURBS, WALKS, DRAINAGE PONDS & PROJECT'S BOUNDARY.
 - 15.) SYMBOLS SHOWN ARE NOT TO SCALE; REFER TO DETAILS FOR DIMENSIONS AND PLACEMENT OR COORDINATE WITH ENGINEER IF NOT SHOWN.
 - 16.) REFER TO ARCHITECTURAL PLANS FOR JOINT LOCATIONS ON ALL CONCRETE WALKS AND PAVEMENTS.
 - 17.) WATERLINE MUST BE INSTALLED BY AN CITY OF EDINBURG APPROVED CONTRACTOR TO CITY OF EDINBURG SPECIFICATIONS.
 - 18.) ALL EXPOSED VERTICAL CONCRETE SURFACES (SCREEN/RETAINING WALL) SHALL BE FREE OF HONEY COMBS AND DISCOLORATION. CONCRETE SHALL HAVE A SMOOTH SURFACE.
 - 19.) CONTRACTOR TO BE FAMILIAR WITH ANY SPECIAL CONSTRUCTION REQUIREMENTS WHILE WORKING WITHIN THE CITY OF EDINBURG.
 - 20.) CONTRACTOR SHALL INCLUDE IN HIS BID A TOTAL OF 3 ADDITIONAL CONFLICT MAN HOLES. ANY NOT UTILIZED DURING CONSTRUCTION SHALL BE CREDITED BACK TO THE OWNER AT THE END OF THE PROJECT CONSTRUCTION AT \$3,200 EACH..

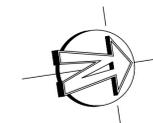

**PROPOSED UTILITY
LAYOUT - ALTERNATES**
SCALE: 1"=30'



**HINOJOSA
ENGINEERING, INC.**
STRUCTURAL ENGINEERING
CIVIL ENGINEERING • LAND SURVEYING
108 W. 18TH ST. MISSION, TEXAS
(956) 581-0143 FAX: (956) 581-2074
E-MAIL: HinojosaEnginc@aol.com
REGISTRATION NUMBER F-908 EXPIRATION DATE 9/30/2016

EDINBURG FIRE STATION # 5
CITY OF EDINBURG
JASMAN RD & FM 2812

PROJECT NUMBER
15-119
DATE
09-16-2015
ADDENDUM #1 1-07-16

S H E E T
C5A
OF




Milnet
Architectural
Services


AMERICAN INSTITUTE OF ARCHITECTS

General Notes:


- Strip the top 6" of topsoil and vegetation from proposed paving and sidewalks. Stripped topsoil may be stockpiled and used for fill in landscape and lawn areas provided it is free of rocks and trash.
- Fill below proposed pavement areas may select fill with plasticity index ranging from 5-17%.
- Refer to the structural plans for fill below proposed building foundation.
- All sidewalks shall have a minimum slope of 1/4" per foot. Elevations of top of curb near building assume 1/4" per foot slope across covered entry and sidewalk.
- All gutters shall have a minimum slope of 0.2%. Unless otherwise noted on the plans.
- Expansion joints to be placed where building foundation meets concrete pavement or sidewalk.
- Contractor to notify all utility companies 48 hours prior to construction of any site improvements for location of gas lines, telephone lines, television cables, water lines and sewer lines.
- All required select fill to be placed in 6" lifts with compaction to 95% proctor.
- All curb and gutter to be backfilled and stabilized as required.
- All grading to be established to provide surface to drainage.
- Construction pad to be graded as required to facilitate drainage run-off from construction site. Silt Fence And/Or Silt Traps Shall Be Provided Before Discharge Of Run-Off From Construction Site To Street Drainage. Contractor shall be responsible for compliance with Federal, state, & local permits regarding storm water pollution prevention.
- All obstructions buildings, poles, wires, stabs, fencing, or guard rails conflicting with the proposed improvements to be removed, relocated and or disposed of by contractor as per engineers written instructions.
- Contractor to match transition of new pavement to existing pavement as proposed by engineer.
- Handicap signage to conform with federal regulations (A.D.A.).
- Contractor to include all striping for parking lots.
- Civil engineer will not provide construction staking on (on-site) improvements.
- Contractor to grade swales as required from sidewalk drainage openings, fire lanes, culverts and curb slots to inlets.
- Contractor to verify horizontal and vertical location of new and/or existing utilities which may conflict with proposed alignment of new facilities.
- Contractor shall be familiar with special construction requirements while working within Edinburg, Texas.
- All excavation and trenching operations shall be conducted in accordance with all safety osha publication 2226 and as required in house bill 662 passed by the Texas legislature.
- Contractor shall provide Erosion and Sediment Control Plans and attain required permits.

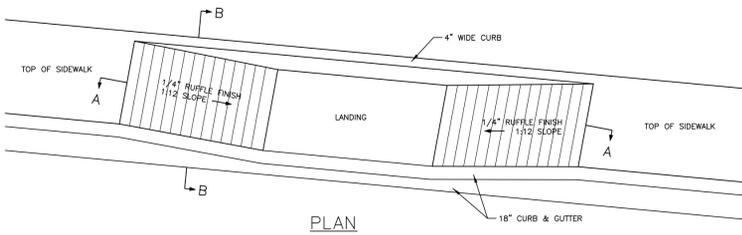


PLAN

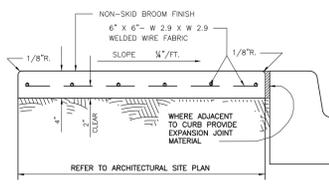

SIDEWALK DETAIL

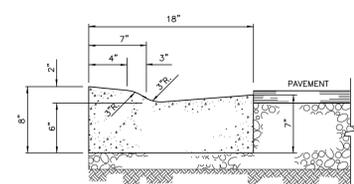


CONC LAY DOWN CURB & GUTTER DETAIL

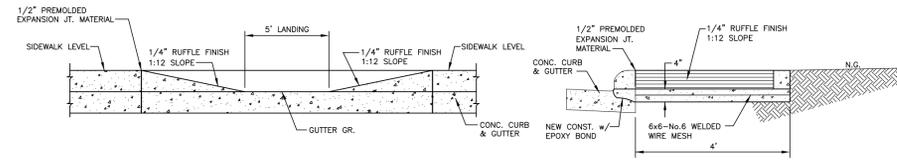


SECTION "A-A"

SECTION "B-B"



SIDEWALK RAMP DETAILS

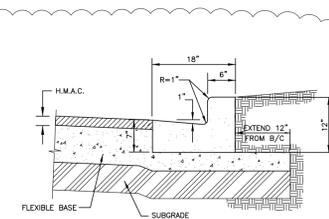


TYPICAL CONCRETE CURB & GUTTER

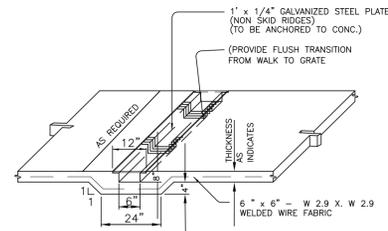

SIDEWALK TRENCH DRAIN

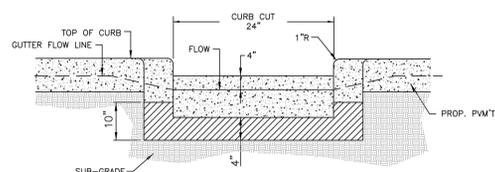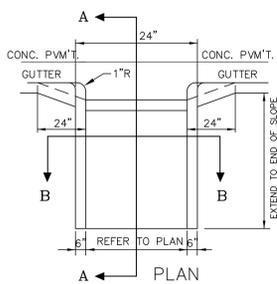


SECTION B-B

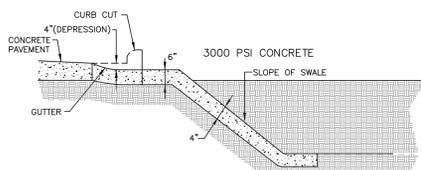


SECTION A-A


CURB OPENNING w/CONC. SPILLWAY

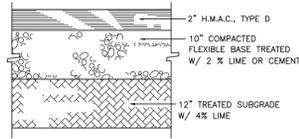


LIGHT DUTY ASPHALT PVM'T. SECTION

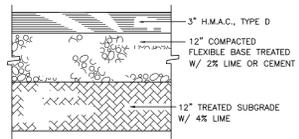


HEAVY DUTY ASPHALT PVM'T. SECTION

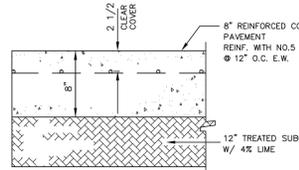


HEAVY DUTY CONC. PVM'T. SECTION
CONC. STRENGTH: 5000 PSI @ 28 DAY

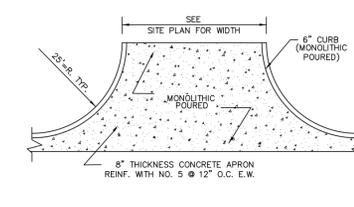


TYPICAL CONCRETE APRON

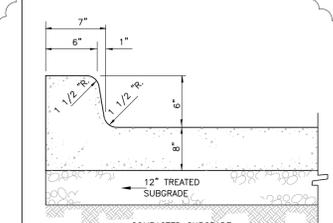

MONOLITHIC CURB

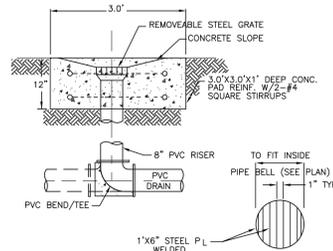


BEE HIVE INLETS

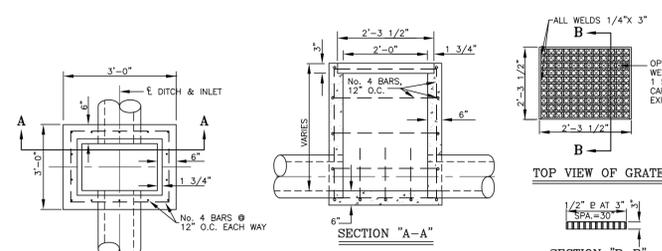

TOP VIEW OF INLET

GRATED INLET

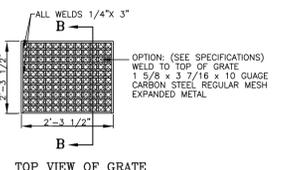


TOP VIEW OF GRATE


SECTION "A-A"

SECTION "B-B"


PIPE DIA. (IN.)	3:1	4:1	5:1	6:1
15"	2'-9"	3'-8"	4'-7"	5'-8"
18"	3'-6"	4'-8"	5'-10"	7'-0"
24"	5'-4"	6'-10"	8'-6"	10'-8"
30"	6'-10"	9'-4"	11'-6"	13'-7"

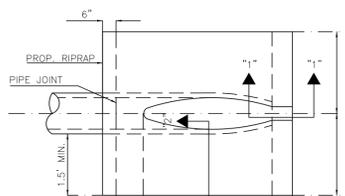


PLAN VIEW

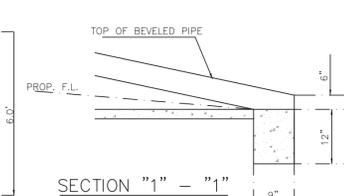

SECTION "1-1"

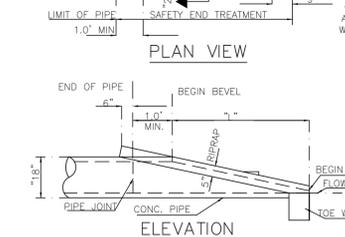

ELEVATION

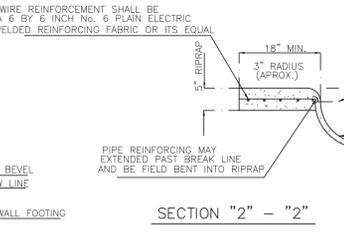

SECTION "2-2"

SAFETY END TREATMENT

PROPOSED PAVING AND DRAINAGE DETAILS



HINOJOSA ENGINEERING, INC.
 STRUCTURAL ENGINEERING
 CIVIL ENGINEERING • LAND SURVEYING
 108 W. 18TH ST. MISSION, TEXAS
 (956) 581-0143 FAX: (956) 581-2074
 E-MAIL: HinojosaEngInc@aol.com
 REGISTRATION NUMBER F-908 EXPIRATION DATE 9/30/2016

EDINBURG FIRE STATION # 5

CITY OF EDINBURG
JASMAN RD & FM 2812

PROJECT NUMBER
15-119

DATE
09-16-2015
ADDENDUM #1 1-07-16

SHEET

C7

OF

GENERAL NOTES

- 1. THIS CONTRACT STRUCTURAL DRAWINGS AND SPECIFICATIONS REPRESENT THE FINISHED STRUCTURE...
2. ALL CONSTRUCTION AND QUALITY OF MATERIALS SHALL COMPLY WITH THE GOVERNING BUILDING CODES AND REGULATIONS.
3. THE CONTRACTOR SHALL VERIFY ALL DIMENSIONS, ELEVATIONS, TOLERANCES AND CONDITIONS AT THE JOB SITE BEFORE COMMENCEMENT OF WORK...

DESIGN CRITERIA

- 1. DESIGN LOADS, STRUCTURAL ANALYSIS AND PREPARATIONS OF STRUCTURAL MEMBERS IS BASED UPON THE FOLLOWING CRITERIA:
2. CODE: IBC 2012
3. ROOF DEAD LOAD:
A. CONVENTIONAL BUILDING: 20 PSF
B. COLLATERAL LOAD (JOIST BOTTOM CHORD): 5 PSF
4. ROOF LIVE LOAD (REDUCIBLE): 20 PSF
5. ROOF RAIN LOAD: 0 PSF
6. ROOF SNOW LOAD DATA:
A. GROUND SNOW LOAD, P_g: 0 PSF
7. MEZZANINE DEAD LOAD: 45 PSF
8. MEZZANINE LIVE LOAD: 125 PSF
9. WIND DESIGN DATA (ASCE 7):
A. ULTIMATE DESIGN WIND SPEED:
(1) (3-SECOND GUST), V_u: 140 MPH
(2) (V_50): 110 MPH
B. RISK CATEGORY: IV
C. WIND EXPOSURE: C
D. INTERNAL PRESSURE COEFFICIENT: SEE TABLE
E. COMPONENTS AND CLADDING: SEE TABLE
11. EARTHQUAKE DESIGN DATA:
A. RISK CATEGORY: IV
B. SEISMIC IMPORTANCE FACTOR, I_p: 1.5
C. MAPPED SPECTRAL RESPONSE ACCELERATION: 0.045g & 0.015g
D. SITE CLASS: D
E. DESIGN SPECTRAL RESPONSE ACCELERATION: 0.048g & 0.024g
12. GEOTECHNICAL INFORMATION:
A. PREPARED BY: L & G CONSULTING ENGINEERS, INC
PROJECT NO.: GL15013
DATE: AUGUST 27, 2015
B. SHALLOW FOUNDATION MINIMUM FOOTING DEPTH BELOW F.G.E.: 24 INCHES
MINIMUM FOOTING WIDTH: 12 INCHES
ALLOWABLE BEARING PRESSURE (CONTINUOUS FOOTING): 375 PSF
ALLOWABLE BEARING PRESSURE (INSULATED FOOTING): 450 PSF
WIRE REINFORCEMENT INSTITUTE (WRI) CRITERIA
FOR EXISTING CONDITIONS:
EFFECTIVE PLASTICITY INDEX: 15
CLIMATIC RATING C_w: 0.3 INCHES
SOIL SUPPORT INDEX (C): PVR
FOR PROPOSED CONDITIONS:
EFFECTIVE PLASTICITY INDEX: 11
CLIMATIC RATING C_w: 15
SOIL SUPPORT INDEX (C): PVR

STRUCTURAL OBSERVATIONS

- 1. JOB SITE OBSERVATIONS BY THE PROFESSIONAL ENGINEER OR HIS AUTHORIZED REPRESENTATIVE SHALL CONSIST OF VISUAL OBSERVATION OF MATERIALS, EQUIPMENT OR CONSTRUCTION WORK FOR THE PURPOSE OF ASCERTAINING THAT THE WORK IS IN SUBSTANTIAL CONFORMANCE WITH THE CONTRACT DOCUMENTS AND WITH THE INTENT.
2. SUCH OBSERVATIONS SHALL NOT BE RELIED UPON BY OTHERS AS ACCEPTANCE OF THE WORK, NOR SHALL IT BE CONSTRUED TO RELIEVE THE CONTRACTOR IN ANY WAY FROM HIS OBLIGATIONS AND RESPONSIBILITIES UNDER THE CONSTRUCTION CONTRACT.
3. SPECIFICALLY BUT WITHOUT LIMITATION, OBSERVATIONS BY THE DESIGN PROFESSIONAL SHALL NOT REQUIRE THE DESIGN PROFESSIONAL TO ASSUME RESPONSIBILITY FOR THE MEANS AND METHODS OF CONSTRUCTION, NOR FOR SAFETY ON THE JOB SITE, NOR FOR ITEMS NOT INSTALLED OR IMPROPERLY INSTALLED BY THE CONTRACTOR OR HIS SUBCONTRACTORS.
4. NOTIFY ENGINEER 48 HOURS IN ADVANCE WHEN A STRUCTURAL OBSERVATION IS REQUIRED.
5. CONSTRUCTION STAGE REQUIRED:
BEFORE PLACEMENT OF CONCRETE FOR SLAB/FOUNDATION: X
BEFORE PLACEMENT OF FOUR (4) FEET OF GROUT IN CMU & BMU WALL: X
AFTER FRAMING OF ROOF STRUCTURE BUT BEFORE PLACEMENT OF ROOFING MATERIAL: X

SHOP DRAWINGS AND SUBMITTALS

- 1. SHOP DRAWINGS SHALL BE PREPARED AND SUBMITTED FOR REVIEW TO THE STRUCTURAL ENGINEER FOR EACH STRUCTURAL BUILDING MATERIAL AS INDICATED IN THE DRAWING GENERAL NOTES AND THE CONTRACT SPECIFICATIONS.
2. SHOP DRAWINGS SHALL USE DRAFTING LINE WORK AND LETTERING THAT IS CLEARLY LEGIBLE. SHOP DRAWINGS SHALL NOT CONTAIN NO REPRODUCTIONS OF THE CONTRACT DRAWING PLANS OR DETAILS.
3. SUBMIT ONE REPRODUCIBLE VELLUM AND ONE COPY OF EACH SHOP DRAWING.
4. SHOP DRAWINGS SHALL NOT SHOW MATERIALS FOR MORE THAN ONE LEVEL OF THE SAME PLAN.
5. SHOP DRAWINGS SHALL SHOW CLEAR AND COMPLETE INFORMATION FOR THE FABRICATION (DETAIL SHEETS AND/OR MATERIAL LISTS) AND INSTALLATION.
6. ALLOW A MINIMUM OF (2) WEEKS FOR REVIEW OF EACH SET OF SHOP DRAWINGS.
7. CONTRACTOR SHALL REVIEW THE SHOP DRAWINGS SUBMITTED BY THE SUB-CONTRACTOR AND COORDINATE SHOP DRAWINGS WITH ALL OTHER TRADES PRIOR TO SUBMITTING THEM FOR ENGINEER REVIEW.
8. CONTRACTOR SHALL ANSWER ALL QUESTIONS OR CLARIFICATIONS BY THE SUB-CONTRACTOR BEFORE SUBMITTING TO ENGINEER FOR REVIEW. ANY QUESTIONS THAT THE CONTRACTOR CANNOT ANSWER WITH THE INFORMATION ON THE DRAWINGS SHALL CLEARLY BE MARKED FOR THE ENGINEER FOR REVIEW.
9. CONTRACTOR IS RESPONSIBLE FOR VERIFYING ALL DIMENSIONS. SEE NOTE NUMBER 3 UNDER GENERAL NOTES.
10. REVIEW OF SHOP DRAWINGS BY THE ENGINEER IS FOR GENERAL CONFORMANCE TO THE STRUCTURAL DRAWINGS. APPROVAL OF THE SHOP DRAWINGS BY THE ENGINEER DOES NOT RELIEF THE CONTRACTOR FOR ANY ERRORS IN DIMENSIONS OR MATERIALS SPECIFIED ON THE DRAWINGS.
11. IF THERE IS ANY DISCREPANCY BETWEEN THE STRUCTURAL DRAWINGS AND SHOP DRAWINGS, THE INFORMATION SHOWN ON THE STRUCTURAL DRAWINGS GOVERN. INFORMATION THAT IS NOT INDICATED ON THE SHOP DRAWINGS SHALL BE OBTAINED FROM THE STRUCTURAL DRAWINGS.
12. PROVIDE SUBMITTALS FOR THE FOLLOWING ITEMS:

Table with 2 columns: ITEM and REQUIRED. Items include concrete mix design, curing compound, reinforcing steel, structural steel, steel joist, metal decking, mortar mix design, grout mix design, masonry assemblage, and pre-manufactured metal building.

REINFORCING STEEL

- 1. BAR REINFORCEMENT SHALL CONFORM TO THE FOLLOWING GRADES OF ASTM A615, INCLUDING SUPPLEMENT S1, GRADE 40 - #3 AND SMALLER, GRADE 60 - #4 AND LARGER.
2. DETAILS OF REINFORCEMENT SHALL BE IN ACCORDANCE WITH CHAPTER 7 OF THE AMERICAN CONCRETE INSTITUTE (ACI) 318, UNLESS OTHERWISE NOTED.
3. VERTICAL REINFORCEMENT SHALL BE TIED AND FINISHED IN POSITION AT THE TOP AND BOTTOM AND AT INTERMEDIATE LOCATIONS, SPACED NOT GREATER THAN 48 INCHES O.C.
4. WELDED STEEL WIRE FABRIC REINFORCEMENT SHALL CONFORM TO ASTM A185.
5. LAPS OF WELDED STEEL WIRE FABRIC AT SPLICES SHALL BE NOT LESS THAN 12 INCHES.
6. WALLS, PILASTERS, COLUMNS SHALL BE DOWELED TO THE SUPPORTING FOOTINGS WITH REINFORCEMENT OF THE SAME SIZE, GRADE AND AT THE SAME SPACING AS THE VERTICAL REINFORCEMENT IN THE WALLS, PILASTERS, OR COLUMNS.
7. BAR SUPPORTS SHALL BE PROVIDED IN ACCORDANCE WITH THE PROVISIONS OF 'BAR SUPPORT SPECIFICATIONS' AS CONTAINED IN THE LATEST EDITION OF THE 'MANUAL OF STANDARD PRACTICE' BY THE CONCRETE REINFORCING STEEL INSTITUTE (CRSI), EXCEPT AS NOTED.
8. GRADE SHALL BE CONCRETE BLOCKS.
9. ALL REINFORCEMENT SHALL BE SECURELY TIED IN PLACE BEFORE PLACING CONCRETE OR GROUT.
10. PROVIDE CORNER BARS TOP AND BOTTOM AT ALL BEAM CORNERS AND DEAD END BEAM INTERSECTIONS. BARS TO EQUAL SIZE AND QUANTITY OF THE NOTED BEAM STEEL BARS SHALL LAP BEAM REINFORCEMENTS.
11. BARS DETAILED AS CONTINUOUS SHALL BE LAPPED AT SPLICES.
12. EXTEND THE SLAB REINFORCING STEEL PERPENDICULAR TO BEAM TO THE TOP OUTSIDE REINFORCING BAR OF PERIMETER BEAMS. START THE SLAB REINFORCING STEEL, PARALLEL TO BEAM, NOT MORE THAN 8" FROM THE TOP INSIDE REINFORCING BAR OF PERIMETER BEAMS.
13. PROVIDE #4 'Z' BARS AT 12" ON CENTER WHERE THE SLAB STEPS DOWN MORE THAN 2".
14. THE 'Z' BARS SHALL LAP THE MAIN SLAB REINFORCING STEEL.
15. ALL CONDUIT OR PLUMBING LINES IN SLAB SHALL BE PLACED BELOW SLAB THICKNESS AREA. ALL CONDUIT NO GREATER THAN 1" DIAMETER MAY BE PLACED IN CENTER OF SLAB. NO CONDUITS OR PLUMBING LINES GREATER THAN 1 INCH ALLOWED IN THE SLAB.
16. WELDING OF CROSSING BARS AND TACK WELDING OF REINFORCEMENT SHALL NOT BE PERMITTED.
17. WELDING OF REINFORCING STEEL IS NOT PERMITTED.
18. CONTRACTOR SHALL SUBMIT REINFORCING STEEL SHOP DRAWINGS FOR REVIEW BEFORE FABRICATION AND INSTALLATION.
19. LAPS AT BAR SPLICES, UNLESS NOTED OTHERWISE, SHALL BE AS FOLLOWS:
MASONRY - GRADE 60: LAP 50 DIA. (30" MIN.)
GRADE 40: LAP 48 DIA. (24" MIN.)
CONCRETE - LAP PER SCHEDULE BELOW

Table with 4 columns: EXPOSURE CONDITION, MINIMUM COVER, TOLERANCE COVER. Rows include drilled piers, footings, concrete surfaces, and slabs on grade.

SPECIAL NOTES TO OWNER

- 1. UNDER NORMAL CONDITIONS, AND FOR CONVENTIONAL BUILDINGS SUCH AS THE SUBJECT MATTER, REINFORCED CONCRETE AND MASONRY DEVELOP CRACKS. THE CRACKS ARE DUE TO INHERENT SHRINKAGE OF CONCRETE, CREEP, AND RESTRAINING EFFECTS OF VERTICAL AND OTHER STRUCTURAL ELEMENTS TO WHICH THE BEAMS/SLABS ARE TIED.
2. THE CRACKS FORMED ARE NORMALLY COSMETIC. THE SLAB MAINTAINS ITS SERVICEABILITY AND STRENGTH REQUIREMENTS. IT IS EMPHASIZED THAT ALL HIGH STRENGTH STEEL IS MADE TO REDUCE THE POTENTIAL CAUSES AND NUMBER OF SUCH CRACKS. IT IS NOT PRACTICAL TO PROVIDE TOTAL ARTICULATION BETWEEN THE FLOOR SYSTEM AND ITS SUPPORTS AND THEREBY ACHIEVE COMPLETE INHIBITION OF ALL CRACKS.
3. MOST SUCH CRACKS DEVELOP OVER THE FIRST THREE YEARS OF THE LIFE OF THE FLOOR SYSTEM. CRACKS WHICH ARE WIDER THAN 0.01 INCH MAY NEED TO BE PRESSURE EPOXIED, REFER TO THE NOTES UNDER 'ALLOWANCES'.
4. THE OBJECT OF THE JOINTS PROVIDED IS TO ALLOW MOVEMENT. MOVEMENTS DUE TO CREEP AND SHRINKAGE MAY BE NOTICEABLE AT JOINTS UP TO TWO YEARS AFTER CONSTRUCTION, BEYOND WHICH MOVEMENTS DUE TO VARIATIONS IN TEMPERATURE WILL PERSIST.

STRUCTURAL STEEL

- 1. MATERIALS AND WORKMANSHIP SHALL CONFORM TO THE LATEST EDITION OF THE AISC SPECIFICATIONS FOR THE DESIGN, FABRICATION, AND ERECTION OF STRUCTURAL STEEL FOR BUILDINGS.
2. STRUCTURAL STEEL SHALL COMPLY WITH THE FOLLOWING ASTM DESIGNATIONS:
MATERIAL DESIGNATION STRENGTH
ANCHOR BOLTS A36 Fy=36 ksi
PLATES A36 Fy=36 ksi
ANGLES A36 Fy=36 ksi
CHANNELS A36 Fy=36 ksi
WIDE FLANGE SHAPES A572 GRADE B Fy=50 ksi
STEEL PIPE A53 GRADE B Fy=35 ksi
SQUARE & RECT. STEEL TUBES (HSS) A500 GRADE B Fy=46 ksi
ROUND TUBES (HSS) 500 GRADE B Fy=42 ksi
3. ALL STRUCTURAL STEEL SHALL BE FABRICATED, ERECTED, AND PAINTED IN ACCORDANCE WITH THE SPECIFICATIONS FOR THE DESIGN, FABRICATION, AND ERECTION OF STRUCTURAL STEEL FOR BUILDINGS AS AMENDED TO DATE AND THE CODE OF STANDARD PRACTICE, LATEST EDITION AS ADOPTED BY THE AMERICAN INSTITUTE OF STEEL CONSTRUCTION, AMENDED AS FOLLOWS:
SECTION 4.2.1. DELETE FIRST TWO SENTENCES.
SECTION 7. ALL REFERENCE TO OWNER SHALL BE CHANGED TO GENERAL CONTRACTOR.
SECTION 7.9.3. THE CONTRACTOR SHALL PROVIDE THE SEQUENCE AND SCHEDULE OF PLACEMENT OF NON-SLIP SUPPORTING STEEL FRAMES.
SECTION 7.9.4. THE CONTRACTOR TO DESIGN SHORES, JACKS OR LOADS.
4. WELDING SHALL BE DONE IN ACCORDANCE WITH THE STANDARD CODE FOR ARC AND GAS WELDING IN BUILDING CONSTRUCTION AS PUBLISHED BY THE AMERICAN WELDING SOCIETY, EXCEPT THAT ALL WELDING SHALL BE DONE BY THE ELECTRIC ARC PROCESS.
5. ALL WELDING SHALL BE PERFORMED BY CERTIFIED WELDERS AND SHALL CONFORM TO ANSII/AWS D1.1-04.
6. DETAILED AND OR SCHEDULED CONNECTIONS HAVE BEEN DESIGNED BY STRUCTURAL ENGINEER. ANY CONNECTION NOT DETAILED OR SCHEDULED OR ALTERED FOR FABRICATION PURPOSES SHALL BE SIZED AND DETAILED BY FABRICATOR AND SHALL BE MARKED FOR ENGINEER'S VERIFICATION. FABRICATOR SIZED AND DETAILED CONNECTIONS SHALL SUPPORT ONE HALF THE TOTAL UNIFORM LOAD CAPACITY SHOWN IN THE TABLES OF UNIFORM CONSTANTS, PART 2 OF THE AISC MANUAL OF STEEL CONSTRUCTION FOR THE GIVEN BEAM, SPAN AND GRADE OF STEEL SPECIFIED. THE EFFECT OF ANY CONCENTRATION LOADS MUST BE TAKEN INTO ACCOUNT.
7. ALL WELDED CONNECTIONS SHALL BE MADE USING 1/4" FILLET WELD, U. N. O.
8. ALL BOLTED CONNECTIONS SHALL BE MADE USING 3/4" DIAMETER HIGH STRENGTH BOLTS, ASTM A325, BEARING TYPE CONNECTION W/ WASHERS ASTM F436, U. N. O. N. O.
9. ALL NUTS SHALL BE PER ASTM A563.
10. ALL CONNECTION PLATES AND STIFFENERS SHALL BE MADE WITH 1/4" THICK PLATES, UNLESS OTHERWISE NOTED ON PLANS.
11. ALL STEEL (INCLUDING BOLTS) EXPOSED TO THE WEATHER SHALL BE HOT DIPPED GALVANIZED, INCLUDES STEEL THAT IS ONLY COVERED WITH PLASTER OR STUCCO). SEE ARCHITECTURAL PLANS IF STRICTER REQUIREMENTS ARE REQUIRED.
12. ALL EXPOSED STEEL SHALL FOLLOW SECTION 10 OF THE CODE OF STANDARD PRACTICE OF AISC, SECTION 10 OF THE CODE ADDRESSES ARCHITECTURALLY EXPOSED STRUCTURAL STEEL (AESS).
13. CONNECTIONS SHALL BE PER HOLLOW STRUCTURAL SECTIONS, CONNX. MANU. BY AISC.
14. WHERE STEEL MEMBER PASS THROUGH CMU WALLS, PROVIDE HALF INCH GAP BETWEEN THE CMU AND THE STEEL MEMBER. PROVIDE ELASTOMERIC MATERIAL BETWEEN THE STEEL MEMBER AND CMU WALL.
15. ALL BEAMS NOT SHOWN SHALL BE W18x35. ALL COLUMNS NOT SHOWN SHALL BE HSS56x14.
16. STEEL SHOP SHALL BE AISC CERTIFIED.
17. HOLES FOR BOLTS IN STRUCTURAL STEEL SHALL BE DRILLED OR PUNCHED. BURNING OF HOLES SHALL NOT BE PERMITTED UNLESS NOTED OTHERWISE. HOLES SHALL BE STANDARD SIZE 1/16 INCH LARGER THAN THE BOLT.
18. ALL STRUCTURAL STEEL SHAPES SHALL BE PRIMED WITH A RUST RESISTANT PRIMER BEFORE SHIPMENT TO THE PROJECT SITE. PRIMER SHALL NOT BE APPLIED TO THE IMMEDIATE AREA OF STEEL INTENDED TO RECEIVE SLIP CRITICAL BOLTED CONNECTIONS.
19. HIGH STRENGTH BOLTS INSTALLATION SHALL BE CONTINUOUSLY INSPECTED BY A SPECIAL INSPECTOR. FOLLOWING ARE REQUIREMENTS OF THE SPECIAL INSPECTOR:
A. HE SHALL VERIFY THE MILL CERTIFICATES FOR MATERIAL.
B. HE SHALL VERIFY THAT THE MATERIAL USED ARE PROPERLY STORED AND PREPARED FOR USE.
C. HE SHALL VERIFY THAT CONSTRUCTION DETAILS, PROCEDURES, TOOL CALIBRATIONS WORKMANSHIP ARE IN ACCORDANCE WITH THE CONSTRUCTION DOCUMENTS AND BUILDING CODE.
D. FOR SNUG-TIGHT CONNECTIONS, HE SHALL VERIFY THAT THE PLIES OF THE CONNECTED ELEMENTS HAVE BEEN BROUGHT INTO SNUG CONTACT WITH EACH OTHER.
E. FOR SLIP-TIGHT CONNECTIONS, HE SHALL VERIFY THE PRETENSION METHOD SELECTED BY THE CONTRACTOR HAS INDUCED THE REQUIRED MINIMUM TENSION IN THE BOLT.
F. A CERTIFICATE OF INSPECTION SHALL BE FURNISHED BY THE SPECIAL INSPECTOR TO THE BUILDING OFFICIAL PRIOR TO HIS INSPECTION AND TO THE ARCHITECT AND ENGINEER.
20. WELDING IN THE FIELD SHALL BE CONTINUOUSLY INSPECTED, BY A SPECIAL INSPECTOR FOLLOWING ARE REQUIREMENTS OF THE SPECIAL INSPECTOR:
A. HE SHALL VERIFY THAT THE MATERIAL USED ARE PROPERLY STORED AND PREPARED FOR USE.
B. HE SHALL VERIFY THE WELDER'S QUALIFICATIONS.
C. HE SHALL VERIFY THAT CONSTRUCTION DETAILS, PROCEDURES AND WORKMANSHIP ARE IN ACCORDANCE WITH THE CONSTRUCTION DOCUMENTS AND BUILDING CODE.
D. A CERTIFICATE OF INSPECTION SHALL BE FURNISHED BY THE SPECIAL INSPECTOR TO THE BUILDING OFFICIAL PRIOR TO HIS INSPECTION AND TO THE ARCHITECT AND ENGINEER.
21. ALL NON SHRINK GROUT FOR LEVELING OF BASE PLATES SHALL HAVE A MINIMUM 5000 PSI COMPRESSIVE STRENGTH AT 28 DAYS. GROUT SHALL COMPLY WITH CORPS OF ENGINEERS SPECIFICATION CRD-C-621.

ABBREVIATIONS

Table with 2 columns: ABBREVIATION and DESCRIPTION. Includes ASML (Above Mean Sea Level), BMU (Brick Masonry Unit), BOM (Bottom of Steel), CMU (Concrete Masonry Unit), TYP (Typical), TOS (Top of Steel), SIM (Similar), and SAT (Similar and Typical).

REINFORCED CONCRETE MASONRY UNIT WALLS

- 1. CONCRETE MASONRY UNITS (CMU) SHALL CONFORM TO ASTM C90, ASTM C426 AND AS FOLLOWS:
* UNIT COMPRESSIVE STRENGTH: 1900 PSI MINIMUM AVERAGE NET 28-DAY COMPRESSIVE STRENGTH, MEDIUM WEIGHT
* WEIGHT CLASSIFICATION:
* CONCRETE MASONRY ASSEMBLAGE (fm) SHALL BE 1500 PSI.
* MORTAR SHALL BE TYPE "S".
2. ALL REINFORCING BARS SHALL BE NEW BILLET STEEL AND SHALL CONFORM TO ASTM A-615, GRADE 60, REINFORCING BARS #3 AND SMALLER MAY BE GRADE 40.
3. CONCRETE SHALL CONFORM TO ASTM C150 TYPE I, LOW ALKALI, MASONRY CEMENTS ARE NOT ALLOWED.
4. UNLESS OTHERWISE TYPICAL, VERTICAL REINFORCEMENT SHALL BE #6 AT 48" ON CENTER, AND TWO (#6) AT JAMBS OF ALL OPENINGS, THREE (#6) AT CORNERS, PROVIDE ADDITIONAL VERTICAL REINFORCEMENT FOR SPECIAL CONDITIONS AS DETAILED. ALL VERTICAL REINFORCEMENT TO BE IN CONCRETE OR GROUT FILLED CELLS. PROVIDE DOWELS FROM FOUNDATION, SAME SIZE AND SPACING.
5. VERTICAL CELLS TO BE FILLED SHALL HAVE VERTICAL ALIGNMENT SUFFICIENT TO MAINTAIN A CLEAR, UNOBSTRUCTED CONTINUOUS VERTICAL.
6. ALL REINFORCING SHALL BE IN PLACE PRIOR TO PLACING CONCRETE OR GROUT.
7. VERTICAL REINFORCING BARS SHALL BE HELD IN POSITION AT THE TOP, BOTTOM AND AT INTERVALS NOT FARTHER APART THAN 50 BAR DIAMETERS.
8. TYPICAL HORIZONTAL REINFORCEMENT SHALL BE TWO (2) #5 CONTINUOUS IN 8'x16" DEEP CONTINUOUS CONCRETE FILLED BOND BEAM BELOW EACH FLOOR AND ROOF LEVEL, UNLESS NOTED OTHERWISE. PROVIDE STANDARD DUR-O-WALL TRUSS-TYPE REINFORCING OR PREVIEWED EQUIVALENT EVERY OTHER COURSE (10" ON CENTER) IN LIEU OF DUR-O-WALL REINFORCING. PLACE TIES NOT LESS THAN 1 1/2" NOR MORE THAN 5" FROM THE SURFACE OF THE COLUMN.
9. WALL LENGTHS LESS THAN OR EQUAL TO FOUR (4) TIMES ITS THICKNESS SHALL BE CONSIDERED COLUMN SECTIONS AND SHALL BE REINFORCED WITH #6 VERTICAL REINFORCING IN FILLED CELLS. PROVIDE 1/4 INCH DIAMETER TIES EVERY COURSE (8" ON CENTER) IN LIEU OF DUR-O-WALL REINFORCING. PLACE TIES NOT LESS THAN 1 1/2" NOR MORE THAN 5" FROM THE SURFACE OF THE COLUMN.
10. PROVIDE HORIZONTAL JOINT REINFORCEMENT EVERY OTHER COURSE WHERE HORIZONTAL BAR REINFORCEMENT IS NOT SPECIFIED.
11. ALL CELLS CONTAINING VERTICAL REINFORCEMENT SHALL BE FILLED SOLIDLY WITH PEEL GRAVEL CONCRETE (3/8" MAX. AGGREGATE SIZE) OR GROUT, EACH WITH A MINIMUM COMPRESSIVE STRENGTH OF 3000 PSI AT 28 DAYS. GROUT OR CONCRETE SHALL BE A WORKABLE MIX SUITABLE FOR PUMPING WITHOUT SEGREGATION AND SHALL BE THOROUGHLY MIXED. GROUT OR CONCRETE SHALL BE PLACED BY PUMPING OR AN APPROVED ALTERNATE METHOD AND SHALL BE PLACED BEFORE INITIAL SET OR IMPRESSION OCCURS. GROUTING SHALL BE PER NCHM TA 3-2.
12. ALLOW C.M.U. WALLS TO SET AT LEAST 24 HOURS AFTER COMPLETION BEFORE GROUTING. GROUT OR CONCRETE SHALL BE CONSOLIDATED BY RECONSOLIDATION AFTER EXCESS MOISTURE HAS BEEN ABSORBED BUT BEFORE WORKABILITY IS LOST. THE FILLING OF ANY SECTION OF A WALL SHALL BE COMPLETED IN ONE DAY WITHOUT INTERRUPTIONS GREATER THAN ONE HOUR, AND PLACED IN LAYERS OF 4 FEET MAXIMUM.
13. WHERE THE CONCRETE OR GROUT POUR EXCEEDS 4 FEET IN HEIGHT, BOTTOM COURSE SHALL BE PROVIDED BY OTHER OPENINGS. THE FACE SHELLS IN THE BOTTOM COURSE OF EACH CELL TO BE FILLED, OR OTHER APPROVED LOCATIONS, THE CLEANOUTS SHALL BE SEALED AFTER INSPECTION AND BEFORE BEING FILLED.
14. WHEN CELL FILLING IS STOPPED FOR ONE HOUR OR LONGER, HORIZONTAL CONSTRUCTION JOINT SHALL BE FORMED BY STOPPING THE POUR OF CONCRETE OR GROUT AT APPROXIMATELY 12 INCH ABOVE THE TOP OF THE CELL.
15. END WALLS AND CROSS WEBS FORMING CELLS TO BE FILLED SHALL BE FULL BEDDED IN MORTAR TO PREVENT LEAKAGE OF CONCRETE OR GROUT UNLESS WALL IS TO BE POURED SOLID.
16. PROVIDE VERTICAL CONTROL JOINTS AT A MAXIMUM SPACING OF 24' (10' FROM CORNERS). DO NOT CONTINUE THE TYPICAL TRUSS TYPE JOINT REINFORCEMENT THROUGH THE JOINT. CONTROL JOINTS LOCATIONS SHALL BE COORDINATED WITH ARCHITECT BUT NOT EXCEED THE MAXIMUM SPACING. BOND BEAM REINFORCEMENT SHALL BE INTERRUPTED AT THE CONTROL JOINT, ALTHOUGH CHORD REINFORCING STEEL AT FLOORS & ROOFS MUST CONTINUE THROUGH THE CONTROL JOINT.
17. DURING ERECTION, COVER TOP OF WALLS, PROJECTIONS AND SILLS WITH WATERPROOF SHEATHING AT THE END OF EACH DAY'S WORK.
18. ALLOW CMU WALL GROUT TO SET AT LEAST 24 HOURS AFTER GROUTING BEFORE CONTINUING BLOCK INSTALLATION ON TOP OF IT.

POST-INSTALLED ANCHORS

- 1. POST-INSTALLED ANCHORS SHALL ONLY BE USED WHERE SPECIFIED ON THE CONSTRUCTION DOCUMENTS. THE CONTRACTOR SHALL OBTAIN APPROVAL FROM THE ENGINEER-OF-RECORD PRIOR TO INSTALLING POST-INSTALLED ANCHORS IN PLACE OF MISSING OR MISPLACED CAST-IN ANCHORS. CARE SHALL BE TAKEN IN PLACING POST-INSTALLED ANCHORS TO AVOID CONFLICTS WITH EXISTING REBAR. HOLES SHALL BE DRILLED AND CLEANED IN ACCORDANCE WITH THE MANUFACTURER'S WRITTEN INSTRUCTIONS. SUBSTITUTION REQUESTS FOR PRODUCTS OTHER THAN THOSE SPECIFIED BELOW SHALL BE SUBMITTED BY THE CONTRACTOR TO THE ENGINEER-OF-RECORD ALONG WITH CALCULATIONS THAT ARE PREPARED & SEALED BY A REGISTERED PROFESSIONAL ENGINEER. THE CONTRACTOR SHALL DEMONSTRATE THAT THE SUBSTITUTED PRODUCT IS CAPABLE OF ACHIEVING THE PERTINENT EQUIVALENT PERFORMANCE VALUES (MINIMUM) OF THE SPECIFIED PRODUCT USING THE APPROPRIATE DESIGN PROCEDURE AND/OR STANDARD(S) AS REQUIRED BY THE BUILDING CODE. PROVIDE CONTINUOUS SPECIAL INSPECTION FOR ALL MECHANICAL AND ADHESIVE ANCHORS PER THE APPLICABLE EVALUATION REPORT. CONTACT MANUFACTURER'S REPRESENTATIVE FOR THE INITIAL TRAINING AND INSTALLATION OF ANCHORS AND FOR PRODUCT RELATED QUESTIONS AND AVAILABILITY. CALL SIMPSON STRONG-TIE AT (800) 999-5999.
A. CONCRETE ANCHORS
1. MECHANICAL ANCHORS SHALL HAVE BEEN TESTED AND QUALIFIED FOR USE IN ACCORDANCE WITH ACI 308.2 AND ICC-ES AC108 FOR CRACKED AND UNCRACKED CONCRETE RECOGNITION. PRE-APPROVED MECHANICAL ANCHORS INCLUDE:
SIMPSON
(1) SIMPSON STRONG-TIE "TITEN-HD" (ICC-ES ESR-2713)
(2) SIMPSON STRONG-TIE "STRONG-BOLT" (ICC-ES ESR-1771)
(3) SIMPSON STRONG-TIE "STRONG-BOLT 2" (ICC-ES ESR-3037)
(4) SIMPSON STRONG-TIE "TORO-CUT" (ICC-ES ESR-2705)
2. ADHESIVE ANCHORS SHALL HAVE BEEN TESTED AND QUALIFIED FOR USE IN ACCORDANCE WITH ICC-ES AC70. PRE-APPROVED ADHESIVE ANCHORS INCLUDE:
SIMPSON
(1) HILTI KWIK HUS E2 AND KWIK E2.1 SCREW ANCHORS PER ICC ESR-3027
(2) HILTI KWIK BOLT-TZ EXPANSION ANCHORS PER ICC ESR-1917
(3) HILTI KWIK BOLT 3 EXPANSION ANCHORS PER ICC ESR-2302
(4) HILTI HDX UNDERCUT ANCHORS PER ICC ESR-1546
(5) HILTI HSI-3 EXPANSION ANCHORS PER ICC ESR-1545
2. ADHESIVE ANCHORS SHALL HAVE BEEN TESTED AND QUALIFIED FOR USE IN ACCORDANCE WITH ACI 308.4 AND ICC-ES AC308 FOR CRACKED AND UNCRACKED CONCRETE RECOGNITION. PRE-APPROVED ADHESIVE ANCHORS INCLUDE:
SIMPSON
(1) SIMPSON STRONG-TIE "SET-XP" (ICC-ES ESR-2138)
HILTI
(1) HILTI HIT-RE 500-SD EPOXY ADHESIVE ANCHORING SYSTEM PER ICC ESR-2322
(2) HILTI HIT-HY 150 MAX-SD ADHESIVE ANCHORING SYSTEM PER ICC ESR-3013
(3) HILTI HIT-HY 150 MAX-SD ADHESIVE ANCHOR SYSTEM PER ICC ESR-2262
(4) STEEL ANCHOR ELEMENT SHALL BE HILTI HIS-N INTERNALLY THREADED INSERTS (USED WITH RE 500-SD ANCHOR 150 MAX ONLY). HILTI HAS CONTINUOUSLY THREADED ROD, CONTINUOUSLY DEFORMED STEEL REBAR.
3. POWDER ACTUATED FASTENERS SHALL HAVE BEEN TESTED AND QUALIFIED FOR USE IN ACCORDANCE WITH ICC-ES AC70. PRE-APPROVED POWDER ACTUATED FASTENERS INCLUDE:
(1) SIMPSON STRONG-TIE "POWER-DRIVEN FASTENERS" (ICC-ES ESR-2138)
B. MASONRY ANCHORS
1. MECHANICAL ANCHORS SHALL HAVE BEEN TESTED AND QUALIFIED FOR USE IN ACCORDANCE WITH ICC-ES AC01 OR AC106. PRE-APPROVED MECHANICAL ANCHORS INCLUDE:
(a) SIMPSON STRONG-TIE "TITEN-HD" (ICC-ES ESR-1056)
(b) SIMPSON STRONG-TIE "STRONG-BOLT 2" (APM)-ES ESR-3240
(c) SIMPSON STRONG-TIE "WEDGE-ALL" (ICC-ES ESR-1396)
(2) ADHESIVE ANCHORS SHALL HAVE BEEN TESTED AND QUALIFIED FOR USE IN ACCORDANCE WITH ICC-ES AC58. PRE-APPROVED ADHESIVE ANCHORS INCLUDE:
(a) SIMPSON STRONG-TIE "SET" (ICC-ES ESR-1772)
2. ANCHORAGE TO HOLLOW CONCRETE MASONRY UNREINFORCED CLAY BRICK MASONRY
SIMPSON
(1) MECHANICAL ANCHORS SHALL HAVE BEEN TESTED AND QUALIFIED FOR USE IN ACCORDANCE WITH ICC-ES AC01 OR AC106. PRE-APPROVED MECHANICAL ANCHORS
(a) SIMPSON STRONG-TIE "TITEN-HD" (ICC-ES ESR-1056)
(2) ADHESIVE ANCHORS WITH SCREEN TUBES SHALL BE TESTED AND QUALIFIED IN ACCORDANCE WITH ICC-ES AC08 OR AC09, AS APPROPRIATE. THE APPROPRIATE SCREEN TUBE SHALL BE USED AS RECOMMENDED BY THE ADHESIVE MANUFACTURER. PRE-APPROVED ADHESIVE ANCHORS WITH SCREEN TUBES INCLUDE:
HILTI: SIMPSON STRONG-TIE "SET" (ICC-ES ESR-1772)
3. ANCHORAGE TO HOLLOW / MULTI-WYTHE MASONRY
HILTI
(1) HILTI HIT-HY 70 MASONRY ADHESIVE ANCHORING SYSTEM PER ICC ESR-3442
(2) STEEL ANCHOR ELEMENT SHALL BE HILTI HIS-E CONTINUOUSLY THREADED ROD OR CONTINUOUSLY DEFORMED STEEL REBAR.
(3) THE APPROPRIATE SIZE SCREEN TUBE SHALL BE USED PER ADHESIVE MANUFACTURERS RECOMMENDATION.

HINOJOSA ENGINEERING, INC. STRUCTURAL ENGINEERING CIVIL ENGINEERING LAND SURVEYING 108 W. 18TH ST. MISSION, TEXAS (956) 581-0143 FAX: (956) 581-2071 E-MAIL: HinojosaEngInc@aol.com REGISTRATION NUMBER 9908 EXPIRATION DATE 09/30/2016

STRUCTURAL MASONRY (SPECIAL INSPECTION)

Table with 3 columns: INSPECTION TASK, CONTINUOUS TASK DURING CONSTRUCTION, PERIODIC TASK DURING CONSTRUCTION. Includes tasks like masonry construction begins, inspection program shall verify, grout placement, and masonry testing requirements.



Minet Architectural Services AMERICAN INSTITUTE OF ARCHITECTS



EDINBURG FIRE STATION #5 CITY OF EDINBURG JASMAN RD & FM2812

PROJECT NUMBER 15-118 DATE 09-16-15 ADDENDUM #1 01-17-16

SHEET STRUCTURAL GENERAL NOTES

S1.1




FOUNDATION SUBGRADE

- PREPARATION OF EXISTING GROUND
 ALL AREAS TO SUPPORT SELECT FILL SHALL BE STRIPPED OF ALL VEGETATION AND/OR ORGANIC TOPSOIL.
 MINIMUM DEPTH OF REMOVAL: 8 INCHES
 EXTEND BEYOND BUILDING FOOT PRINT: 2 FEET
 REMOVE THE EXISTING SUBGRADE SOILS DOWN TO A MINIMUM ELEVATION OF: 80.75' AMSL
 EXTEND BEYOND BUILDING FOOT PRINT: 3 FEET
 THE EXPOSED SUBGRADE SHALL BE SCARIFIED TO A DEPTH OF 6 INCHES AND MOISTURE CONDITIONED FROM 0 TO 3% ABOVE OPTIMUM. THE SUBGRADE SHALL BE COMPACTED TO 95 PERCENT OF THE MAXIMUM DENSITY AS DETERMINED BY THE STANDARD MOISTURE-DENSITY RELATION (ASTM D-698). FOLLOWING COMPLETE CLEARING AND PREPARATION OF THE SITE FOR CONSTRUCTION, THE GEOTECHNICAL ENGINEER SHALL OBSERVE THE SITE TO DETERMINE THAT SATISFACTORY PREPARATION HAS BEEN ACCOMPLISHED.
- SELECT FILL MATERIAL
 A) THE FOLLOWING SOILS, AS CLASSIFIED ACCORDING TO THE USCS MAY BE CONSIDERED SATISFACTORY FOR USE AS SELECT FILL MATERIALS AT THIS SITE:
 SM, SC, GM, GC, CH, MH, AND COMBINATIONS OF THESE SOILS.
 B) AGGREGATE BASE COURSE
 THE CLAYEY GRAVEL AND CALICHE MATERIALS SHOULD MEET THE GRADATION REQUIREMENTS OF ITEM 247, TYPE B, GRADES 1 THROUGH 3 AS SPECIFIED IN THE 2004 TXDOT STANDARD SPECIFICATIONS MANUAL AND A PLASTICITY INDEX BETWEEN 7 AND 10. CRUSHED LIMESTONE OR CRUSHED CONCRETE MATERIAL SHOULD MEET THE REQUIREMENTS OF 2004 TXDOT ITEM 247, TYPE A OR D, GRADE 1. THE SELECT FILL MATERIALS SHOULD BE FREE OF ORGANIC MATERIAL AND DEBRIS, AND SHOULD NOT RETAIN STONES LARGER THAN 2 INCHES IN THE MAXIMUM DIMENSION.
 C) THE FOLLOWING SOILS, AS CLASSIFIED ACCORDING TO THE USCS, ARE NOT CONSIDERED SATISFACTORY FOR USE AS SELECT FILL MATERIALS AT THIS SITE:
 AS, CH, MH, OH, CL AND PT. THE NATURE OF SOILS AT THIS SITE ARE NOT CONSIDERED SUITABLE FOR USE AS SELECTED FILL MATERIAL.
 * FINISH FLOOR SHALL BE 18" MINIMUM ABOVE TOP OF CURB ELEVATION OR 18" MINIMUM ABOVE CROWN OF STREET, OR AS INDICATED ON CIVIL DRAWINGS.
 INCREASE INDICATED AMOUNT OF FILL AS REQUIRED TO ACHIEVE MOST STRINGENT REQUIREMENTS:
 MINIMUM AMOUNT OF SELECT FILL: 45 INCHES
 PLASTICITY INDEX: BETWEEN 8 AND 20
 MAXIMUM LIQUID LIMIT: LESS THAN 40
 NO ORGANIC OR OTHER PERISHABLE MATERIAL
 NO STONES LARGER THAN TWO (2) INCHES
- PLACING SELECT FILL
 FILL LIFTS: NOT EXCEEDING 8 INCHES, LOOSE LIFTS
 MINIMUM AMOUNT OF SELECT FILL: 44 INCHES
- COMPACTION OF SELECT FILL
 MOISTURE: WITHIN (±) 2 PERCENT BELOW TO (3) PERCENT ABOVE OPTIMUM
 ATTERBERG LIMITS: 98 PERCENT MAXIMUM DENSITY, IN ACCORDANCE WITH ASTM D698
 COMPACTION: ONE AT A RATE OF 5,000 CUBIC YARDS, ONE TEST PER 3,000 SQUARE FEET PER LIFT (MINIMUM OF 3 PER LIFT)
- THE SOILS ENGINEER SHALL BE THE OWNERS REPRESENTATIVE TO CONTROL THE PLACEMENT OF COMPACTED FILL. THE SOILS ENGINEER SHALL APPROVE THE SUB-GRADE PREPARATION, THE FILL MATERIALS, THE METHOD OF PLACEMENT AND COMPACTION, SHALL GIVE WRITTEN APPROVAL OF THE COMPLETED FILL.
- THE SOILS REPORT/FOUNDATION INVESTIGATION IS TO BE CONSIDERED A PART OF THESE PLANS AND SHALL BE COMPLIED WITH BY THE CONTRACTOR. ALL EARTHWORK AND GRADING SHALL BE ACCOMPLISHED IN ACCORDANCE WITH THE RECOMMENDATIONS OF THE FOUNDATION INVESTIGATION OR PER NOTES 1 THRU 4 ABOVE WHICHEVER HAS THE MOST STRINGENT REQUIREMENTS.
- IN THE EVENT FOUNDATION EXCAVATIONS ARE CARRIED TO A DEPTH GREATER THAN REQUIRED, THE ADDITIONAL DEPTH SHALL BE FILLED WITH THE SAME CONCRETE AS THAT USED FOR FOOTING AT NO ADDITIONAL EXPENSE TO THE OWNER. NO UNCONTROLLED FILL WILL BE PERMITTED. REFER TO GEOTECHNICAL INVESTIGATION REPORT FOR GROUND WATER ELEVATIONS AND SOIL CONDITIONS. FOUNDATION EXCAVATIONS SHALL BE ANTICIPATED BY THE CONTRACTOR.
- THE FOOTING EXCAVATIONS SHALL BE KEPT FREE FROM LOOSE MATERIAL AND STANDING WATER. THE FOUNDATION EXCAVATIONS SHOULD BE OBSERVED BY THE SOILS ENGINEER PRIOR TO STEEL OR CONCRETE PLACEMENT TO ASSESS THAT THE FOUNDATION MATERIALS ARE CAPABLE OF SUPPORTING THE DESIGN LOADS AND ARE CONSISTENT WITH THE MATERIALS DISCUSSED IN THE REPORT. THIS IS ESPECIALLY IMPORTANT TO IDENTIFY THE ACCEPTABILITY OF THE SUBGRADE OR FILL MATERIAL UNDER THE FOOTING. SOFT OR LOOSE SOIL ZONES ENCOUNTERED AT THE BOTTOM OF THE FOOTING OR BEAM EXCAVATIONS SHOULD BE REMOVED TO THE LEVEL OF COMPACT SOIL AS DIRECTED BY THE GEOTECHNICAL ENGINEER. CAVITIES FORMED AS A RESULT OF EXCAVATION OF SOFT OR LOOSE SOIL ZONES SHOULD BE BACKFILLED WITH LEAN CONCRETE OR SELECT FILL AS DETERMINED BY THE GEOTECHNICAL ENGINEER. CARE SHOULD BE TAKEN TO SHAPE THE BUILDING AREAS SUCH THAT WATER WILL NOT POND AROUND THE STRUCTURE DURING CONSTRUCTION AND CAUSE THE NEAR SURFACE CLAYS TO SWELL. THE PROPOSED STRUCTURE SHALL BE ISOLATED FROM ANY MOISTURE SOURCE WHICH MIGHT ALSO CAUSE SWELLING OF THE CLAYS AFTER COMPLETION OF THE CONSTRUCTION.
- WHEN THE STRUCTURE IS COMPLETE, THE GROUND SURFACE SHOULD SLOPE AWAY FROM THE STRUCTURE AND DOWN SPOUTS SHOULD CARRY RUNOFF WATER SEVERAL FEET FROM THE BUILDING, PREFERABLY INTO PAVED AREAS OR BEWERS, BEFORE DISCHARGING.
- DO NOT PLANT OR LEAVE IN PLACE DEEP ROOTED TREES WITHIN PROXIMITY TO THE PERIMETER OF THE STRUCTURE. DEEP ROOTED TREES HAVE POTENTIAL TO REMOVE MOISTURE FROM BENEATH THE BUILDING IF PLANTED CLOSE ENOUGH TO ALLOW THE ROOT BULB EXTEND NEAR OR BENEATH THE BUILDING.
- AIR CONDITIONING CONDENSER DRAIN LINES TO DISCHARGE WATER A MINIMUM OF 5 FEET FROM THE PERIMETER OF THE STRUCTURE. THE DISCHARGE AREA SHALL HAVE SUFFICIENT SLOPE AWAY FROM THE STRUCTURE TO PREVENT STANDING WATER.

FOUNDATION NOTES

- FOR GENERAL NOTES SEE SHEET S1.1 & S1.2
- FOR TYPICAL DETAILS NOT REFERENCED IN PLAN SEE SHEET S1.3 & S1.4
- CONTRACTOR/SUBCONTRACTOR IS RESPONSIBLE FOR VERIFYING ALL DIMENSIONS WITH ARCHITECTURAL PLANS BEFORE COMMENCING ANY WORK. THE CONTRACTOR/SUBCONTRACTOR SHALL REPORT ANY DISCREPANCIES TO THE ARCHITECT/ENGINEER BEFORE THE WORK HAS BEGUN.
- REFER TO ARCHITECTURAL PLANS FOR ADDITIONAL DIMENSIONS.
- REFER TO ARCHITECTURAL PLANS FOR FLOOR DRAINS.
- 5" THK. SLAB ON GRADE w/ #4 AT 12" O.C. EACH WAY AT MID-DEPTH OF SLAB OVER 15 MIL. STEGO WRAP OVER APPROVED COMPACTED FILL.
- SLAB CONTRACTION JOINT. SEE DETAIL S/S1.3
- FOR DROP IN SLAB ON GRADE. REFER TO DETAIL 1/S1.3
- FOR TYPICAL THICKEN SLAB UNDER CMU WALL. REFER TO DETAIL 11/S1.3
- FOR TYPICAL THICKEN SLAB UNDER CMU WALL WITH DEPRESSED SLAB. REFER TO DETAIL 8/S1.3
- REFERENCE FRAMING PLANS FOR CMU WALL REINFORCEMENT.
- VERIFY ALL SLAB DEPRESSIONS w/ ARCHL DWGS. FOR EXTENT AND LOCATION.

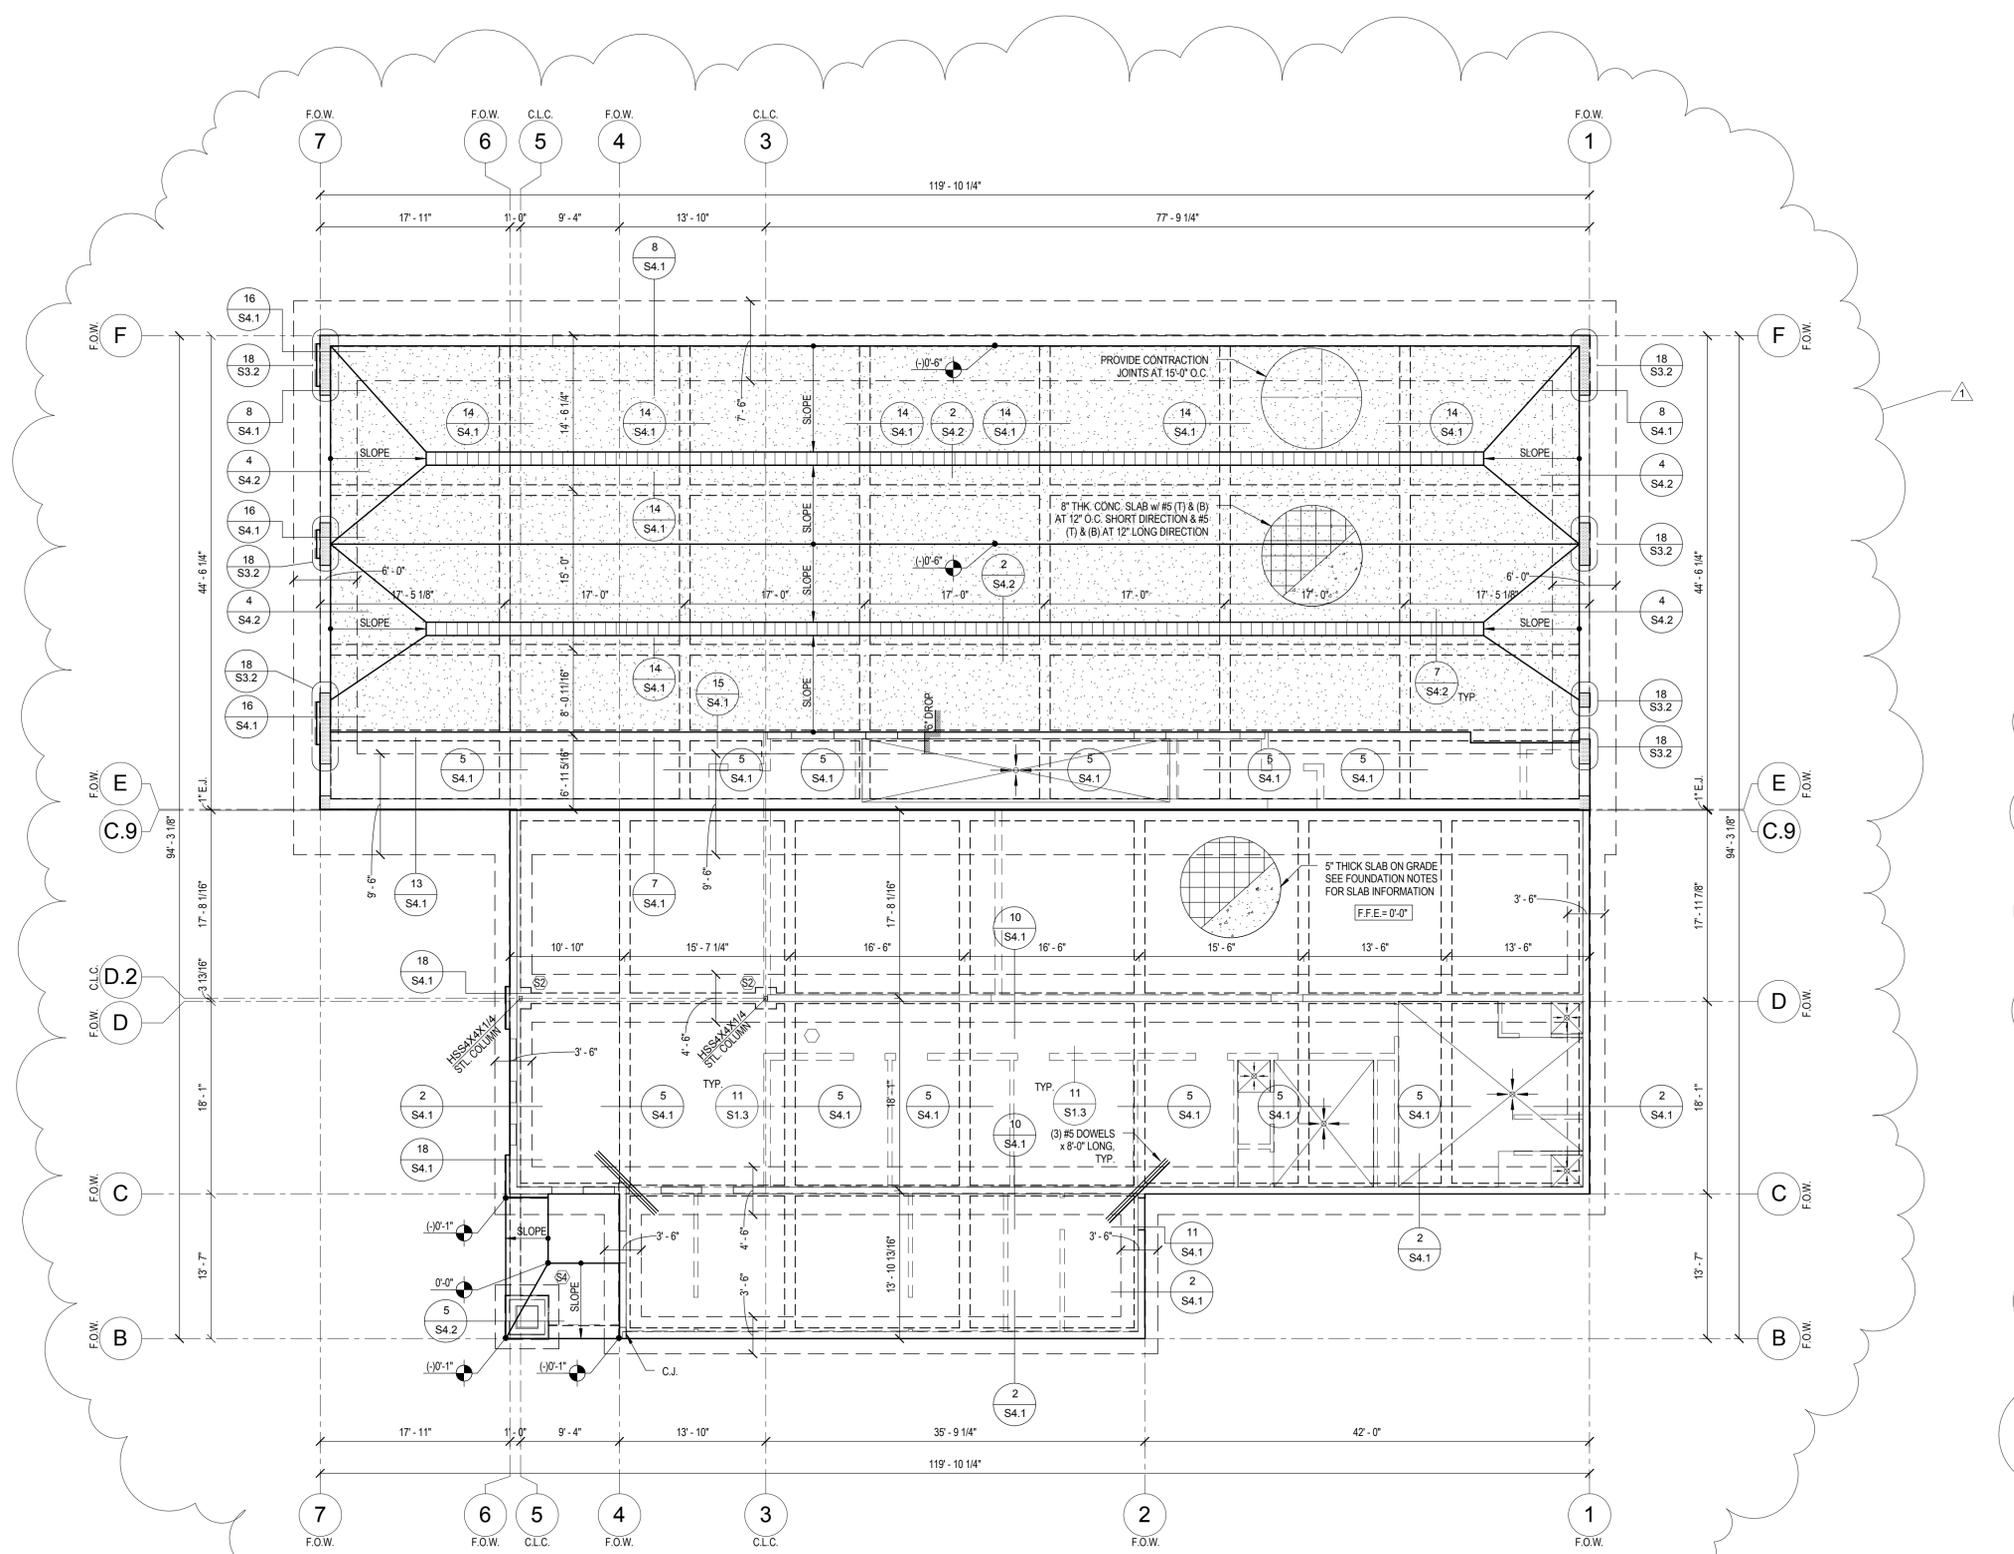

BASE BID
 FOUNDATION PLAN
 1/8" = 1'-0"



HINOJOSA ENGINEERING, INC.
 STRUCTURAL ENGINEERING
 CIVIL ENGINEERING • LAND SURVEYING
 108 W. 18TH ST. MISSION, TEXAS
 (956) 581-0143 FAX: (956) 581-2071
 E-MAIL: HinojosaEng@aol.com
 REGISTRATION NUMBER 9908 EXPIRATION DATE 09/30/2016



Milnet
Architectural
Services
 AMERICAN INSTITUTE OF ARCHITECTS



1-07-18

EDINBURG FIRE STATION #5
 CITY OF EDINBURG
 JASMAN RD & FM2812

PROJECT NUMBER 15-118
 DATE 09-16-15
 ADDENDUM #1 01-07-2016

S H E E T
 STRUCTURAL
 FOUNDATION PLAN

S2.1A


FOUNDATION SUBGRADE



- PREPARATION OF EXISTING GROUND
 ALL AREAS TO SUPPORT SELECT FILL SHALL BE STRIPPED OF ALL VEGETATION AND/OR ORGANIC TOPSOIL.
 MINIMUM DEPTH OF REMOVAL: 8 INCHES
 EXTEND BEYOND BUILDING FOOT PRINT: 2 FEET
 REMOVE THE EXISTING SUBGRADE SOILS DOWN TO A MINIMUM ELEVATION OF: 80.75' AMSL
 EXTEND BEYOND BUILDING FOOT PRINT: 3 FEET
 THE EXPOSED SUBGRADE SHALL BE SCARIFIED TO A DEPTH OF 6 INCHES AND MOISTURE CONDITIONED FROM 0 TO 3% ABOVE OPTIMUM. THE SUBGRADE SHALL BE COMPACTED TO 95 PERCENT OF THE MAXIMUM DENSITY AS DETERMINED BY THE STANDARD MOISTURE-DENSITY RELATION (ASTM D-698), FOLLOWING COMPLETE CLEARING AND PREPARATION OF THE SITE FOR CONSTRUCTION, THE GEOTECHNICAL ENGINEER SHALL OBSERVE THE SITE TO DETERMINE THAT SATISFACTORY PREPARATION HAS BEEN ACCOMPLISHED.
- SELECT FILL MATERIAL
 A) THE FOLLOWING SOILS, AS CLASSIFIED ACCORDING TO THE USCS ARE NOT CONSIDERED SATISFACTORY FOR USE AS SELECT FILL MATERIALS AT THIS SITE: SM, SC, GM, GC, CH, MH, AND COMBINATIONS OF THESE SOILS.
 B) AGGREGATE BASE COURSE
 THE CLAYEY GRAVEL AND CALICHE MATERIALS SHOULD MEET THE GRADATION REQUIREMENTS OF ITEM 247, TYPE B, GRADES 1 THROUGH 3 AS SPECIFIED IN THE 2004 TxDOT STANDARD SPECIFICATIONS MANUAL AND A PLASTICITY INDEX BETWEEN 7 AND 20. CRUSHED LIMESTONE OR CRUSHED CONCRETE MATERIAL SHOULD MEET THE REQUIREMENTS OF 2004 TxDOT ITEM 247, TYPE A OR D GRADE 1. THE SELECT FILL MATERIALS SHOULD BE FREE OF ORGANIC MATERIAL AND DEBRIS, AND SHOULD NOT RETAIN STONES LARGER THAN 2 INCHES IN THE MAXIMUM DIMENSION.
 C) THE FOLLOWING SOILS, AS CLASSIFIED ACCORDING TO THE USCS, ARE NOT CONSIDERED SATISFACTORY FOR USE AS SELECT FILL MATERIALS AT THIS SITE: AS, CH, MH, OH, CL AND PT. THE NATURE OF SOILS AT THIS SITE ARE NOT CONSIDERED SUITABLE FOR USE AS SELECTED FILL MATERIAL.
 * FINISH FLOOR SHALL BE 18" MINIMUM ABOVE TOP OF CURB ELEVATION OR 18" MINIMUM ABOVE CROWN OF STREET, OR AS INDICATED ON CIVIL DRAWINGS, INCREASE INDICATED AMOUNT OF FILL AS REQUIRED TO ACHIEVE MOST STRINGENT REQUIREMENTS.
 MINIMUM AMOUNT OF SELECT FILL: 45 INCHES
 PLASTICITY INDEX: BETWEEN 8 AND 20
 MAXIMUM LIQUID LIMIT: LESS THAN 40
 NO ORGANIC OR OTHER PERISHABLE MATERIAL
 NO STONES LARGER THAN TWO (2) INCHES
- PLACING SELECT FILL
 FILL LIFTS: NOT EXCEEDING 8 INCHES, LOOSE LIFTS
 MINIMUM AMOUNT OF SELECT FILL: 44 INCHES
- COMPACTION OF SELECT FILL
 MOISTURE: WITHIN (-2) PERCENT BELOW TO (3) PERCENT ABOVE OPTIMUM
 COMPACTION: 98 PERCENT MAXIMUM DENSITY, IN ACCORDANCE WITH ASTM D698
 ATTERBERG LIMITS: ONE AT A RATE OF 5,000 CUBIC YARDS.
 COMPACTION: ONE TEST PER 3,000 SQUARE FEET PER LIFT (MINIMUM OF 3 PER LIFT)
- THE SOILS ENGINEER SHALL BE THE OWNERS REPRESENTATIVE TO CONTROL THE PLACEMENT OF COMPACTED FILL. THE SOILS ENGINEER SHALL APPROVE THE SUB-GRADE PREPARATION, THE FILL MATERIALS, THE METHOD OF PLACEMENT AND COMPACTION, SHALL GIVE WRITTEN APPROVAL OF THE COMPLETED FILL.
- THE SOILS REPORT FOUNDATION INVESTIGATION IS TO BE CONSIDERED A PART OF THESE PLANS AND SHALL BE COMPLIED WITH BY THE CONTRACTOR. ALL EARTHWORK AND GRADING SHALL BE ACCOMPLISHED IN ACCORDANCE WITH THE RECOMMENDATIONS OF THE FOUNDATION INVESTIGATION OR PER NOTES 1 THRU 4 ABOVE WHICHEVER HAS THE MOST STRINGENT REQUIREMENTS.
- IN THE EVENT FOUNDATION EXCAVATIONS ARE CARRIED TO A DEPTH GREATER THAN REQUIRED, THE ADDITIONAL DEPTH SHALL BE FILLED WITH THE SAME CONCRETE AS THAT USED FOR FOOTING AT NO ADDITIONAL EXPENSE TO THE OWNER. NO UNCONTROLLED FILL WILL BE PERMITTED. REFER TO GEOTECHNICAL INVESTIGATION REPORT FOR GROUND WATER ELEVATIONS AND SOIL CONDITIONS. DEWATERING SHALL BE ANTICIPATED BY THE CONTRACTOR.
- THE FOOTING EXCAVATIONS SHALL BE KEPT FREE FROM LOOSE MATERIAL AND STANDING WATER. THE FOUNDATION SHALL BE OBSERVED BY THE SOILS ENGINEER PRIOR TO STEEL OR CONCRETE PLACEMENT TO ASSESS THAT THE FOUNDATION MATERIALS ARE CAPABLE OF SUPPORTING THE DESIGN LOADS AND ARE CONSISTENT WITH THE MATERIALS DISCUSSED IN THE REPORT. THIS IS ESPECIALLY IMPORTANT TO IDENTIFY THE ACCEPTABILITY OF THE SUBGRADE OR FILL MATERIAL UNDER THE FOOTING. SOFT OR LOOSE SOIL ZONES SHOULD BE BACKFILLED WITH LEAN CONCRETE OR SELECT FILL AS DETERMINED BY THE GEOTECHNICAL ENGINEER. CARE SHOULD BE TAKEN TO SHAPE THE BUILDING AREAS SUCH THAT WATER WILL NOT POND AROUND THE STRUCTURE DURING CONSTRUCTION AND CAUSE THE NEAR SURFACE CLAYS TO SWELL. THE PROPOSED STRUCTURE SHALL BE ISOLATED FROM ANY MOISTURE SOURCE WHICH MIGHT ALSO CAUSE SWELLING OF THE CLAYS AFTER COMPLETION OF THE CONSTRUCTION.
- WHEN THE STRUCTURE IS COMPLETE, THE GROUND SURFACE SHOULD SLOPE AWAY FROM THE STRUCTURE AND DOWN SPOUTS SHOULD CARRY RUNOFF WATER SEVERAL FEET FROM THE BUILDING. PREVENT WATER FROM INFILTRATING INTO AREAS, BEFORE DISCHARGING. DO NOT PLANT OR LEAVE IN PLACE DEEP ROOTED TREES WITHIN PROXIMITY TO THE PERIMETER OF THE STRUCTURE. DEEP ROOTED TREES HAVE POTENTIAL TO REMOVE MOISTURE FROM BENEATH THE BUILDING IF PLANTED CLOSE ENOUGH TO ALLOW THE ROOT BULB EXTEND NEAR OR BENEATH THE BUILDING.
- AIR CONDITIONING CONDENSER DRAIN LINES TO DISCHARGE WATER A MINIMUM OF 5 FEET FROM THE PERIMETER OF THE STRUCTURE. THE DISCHARGE AREA SHALL HAVE SUFFICIENT SLOPE AWAY FROM THE STRUCTURE TO PREVENT STANDING WATER.

FOUNDATION NOTES

- FOR GENERAL NOTES SEE SHEET S1.1 & S1.2
- FOR TYPICAL DETAILS NOT REFERENCED IN PLAN SEE SHEET S1.3 & S1.4
- CONTRACTOR/SUBCONTRACTOR IS RESPONSIBLE FOR VERIFYING ALL DIMENSIONS WITH ARCHITECTURAL PLANS BEFORE COMMENCING ANY WORK. THE CONTRACTOR/SUBCONTRACTOR SHALL REPORT ANY DISCREPANCIES TO THE ARCHITECT/ENGINEER BEFORE THE WORK HAS BEGUN.
- REFER TO ARCHITECTURAL PLANS FOR ADDITIONAL DIMENSIONS.
- REFER TO ARCHITECTURAL PLANS FOR FLOOR DRAINS.
- 5" THK SLAB ON GRADE w/ #4 AT 12" O.C. EACH WAY AT MID-DEPTH OF SLAB OVER 15 MIL STEGO WRAP OVER APPROVED COMPACTED FILL.
- SLAB CONTRACTION JOINT, SEE DETAIL S/S1.3
- FOR DROP IN SLAB ON GRADE, REFER TO DETAIL 1/S1.3
- FOR TYPICAL THICKENED SLAB UNDER CMU WALL, REFER TO DETAIL 1/S1.3
- FOR TYPICAL THICKENED SLAB UNDER CMU WALL WITH DEPRESSED SLAB, REFER TO DETAIL 8/S1.3
- REFERENCE FRAMING PLANS FOR CMU WALL REINFORCEMENT.
- VERIFY ALL SLAB DEPRESSIONS w/ ARCHL DWGS. FOR EXTENT AND LOCATION.

ALTERNATE #3
FOUNDATION PLAN
 1/8" = 1'-0"

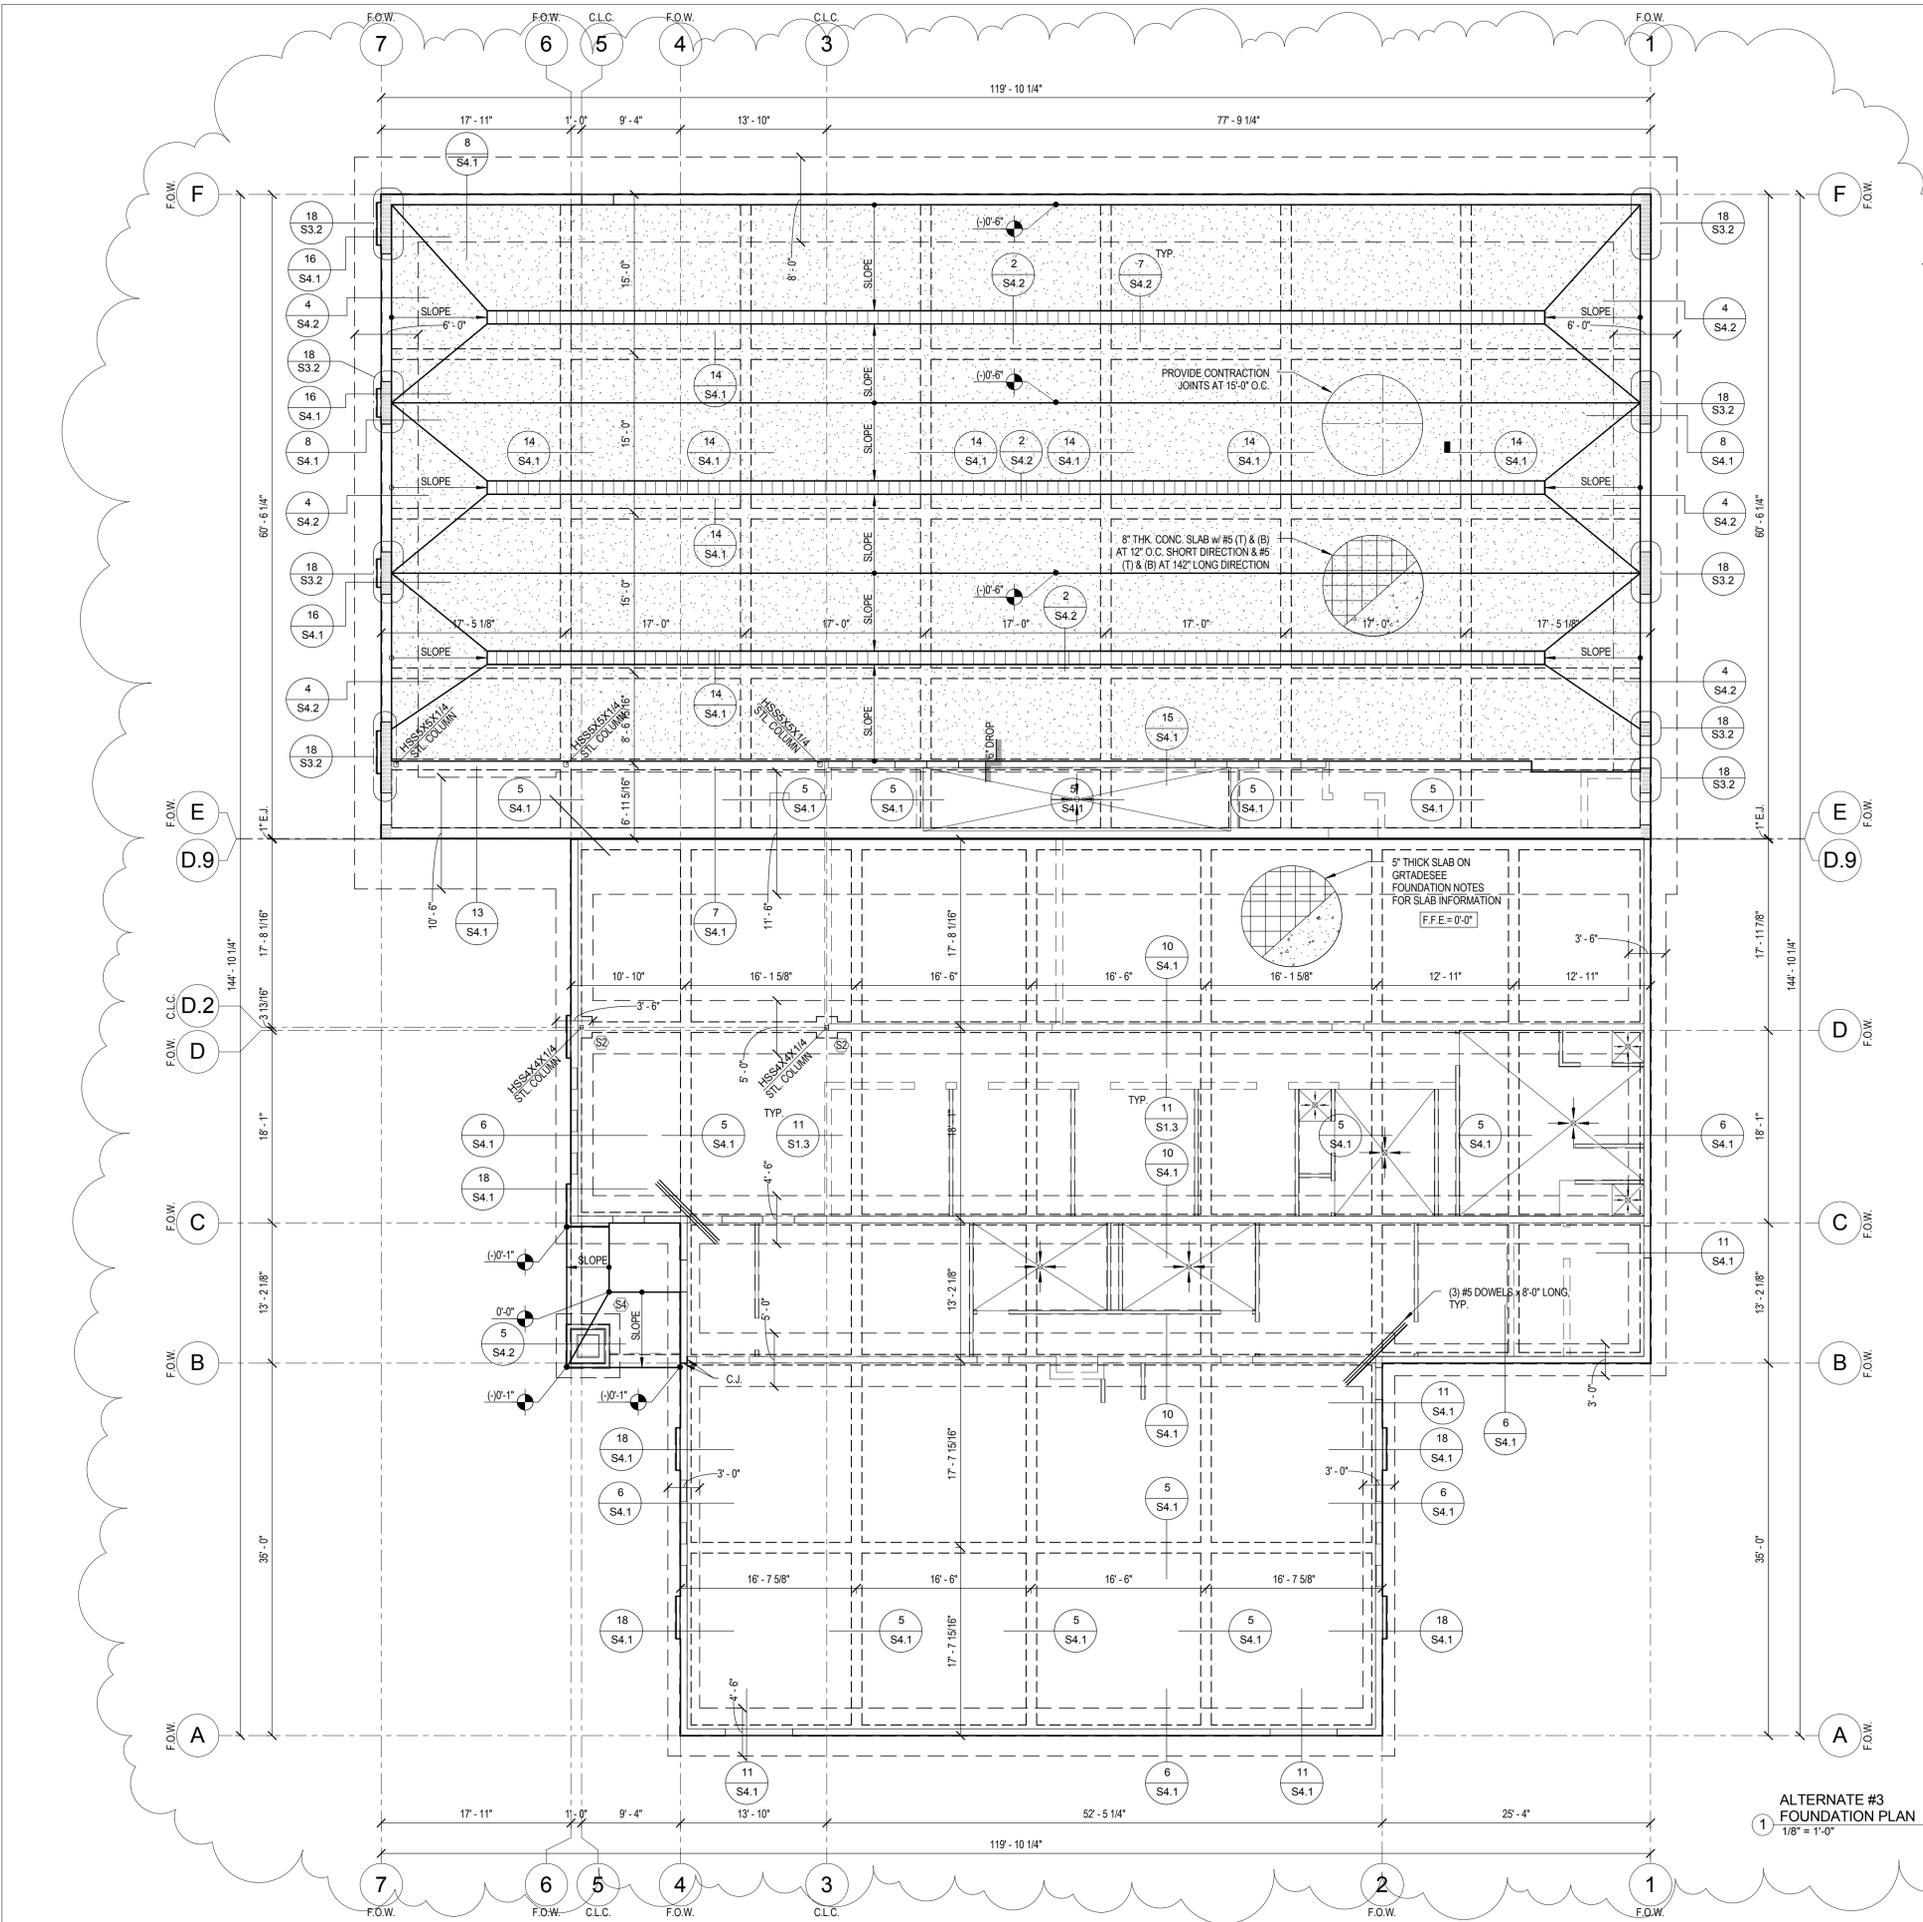

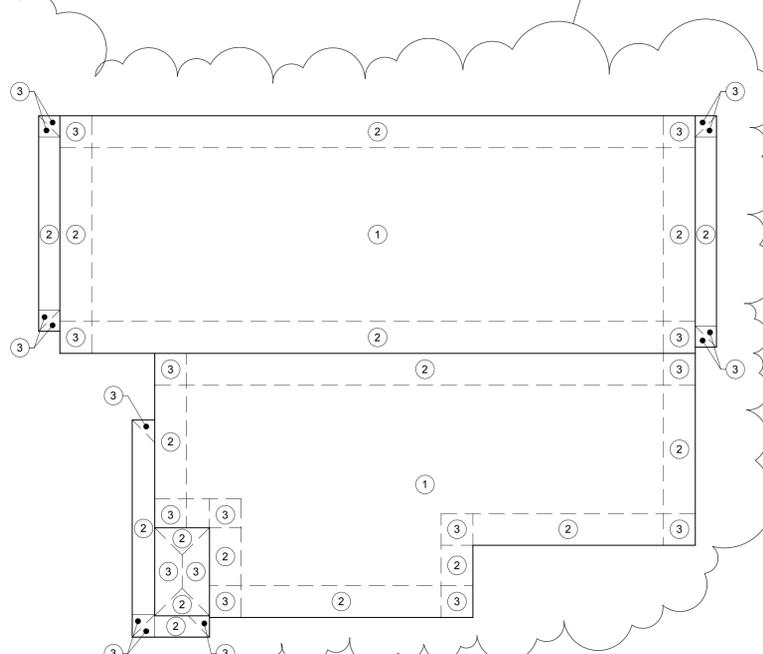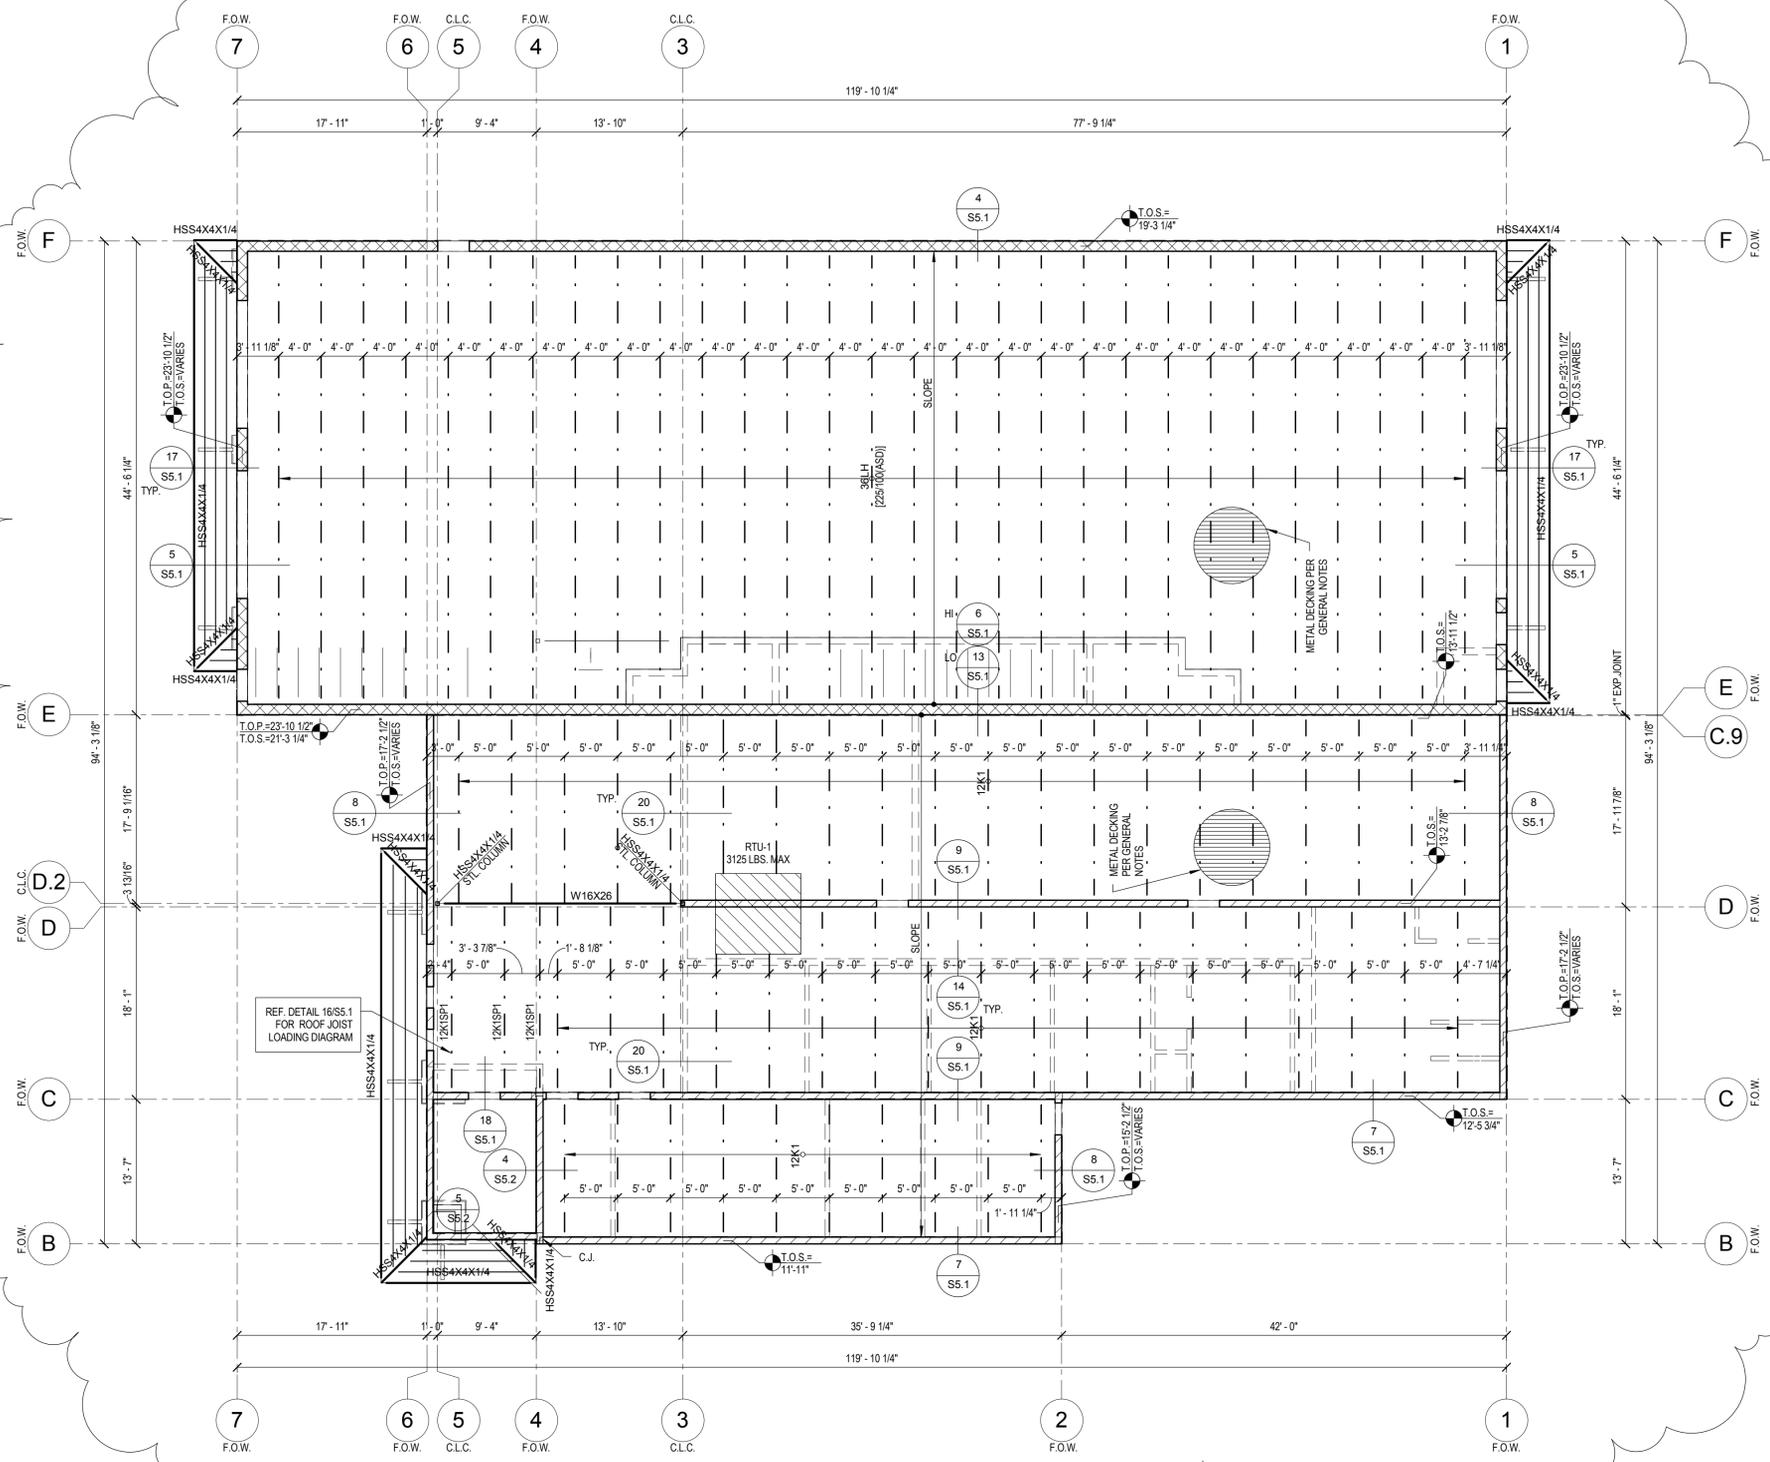

ROOF COMPONENT AND CLADDING GROSS WIND PRESSURES

ROOF ZONE	TRIBUTARY AREA			
	10 SF.	20 SF.	50 SF.	
#1 INTERM.	+18.6	-45.6	+17.4	-44.5
#2 EDGE	+18.6	-76.6	+17.4	-68.4
#3 CORN.	+18.6	-115.2	+17.4	-95.4



(+) INDICATES AN UPWARD DIRECTION
 *WIND PRESSURES SHOWN ARE GROSS VALUES USING LOAD RESISTANCE FACTOR DESIGN (LRFD).
 *NET UPLIFT IS THE GROSS UPLIFT MINUS THE ALLOWABLE PORTION OF DEAD LOAD INCLUDING THE WEIGHT OF THE JOIST.
 EDGE DISTANT (")= 8 ft.
 *ALLOWABLE PORTION OF DEAD LOAD TO BE SUBTRACTED FROM GROSS UPLIFT= 10 PSF.
 *ULTIMATE DESIGN WIND SPEED= 140 MPH.
 1. DOORS & WINDOWS MAXIMUM DESIGN WIND PRESSURES:
 P_w = +4.5 TOWARDS THE SURFACE
 P_w = -61.1 AWAY FROM THE SURFACE
 2. THE STRUCTURE IS DESIGNED TO MEET ASCE 7-10 WIND PRESSURES. ALL COMPONENTS AND CLADDING (EX. WINDOWS, DOORS, RTUS AND ARCHITECTURAL COPING AND ROOFING MATERIALS); SHALL MEET MINIMUM CODE REQUIREMENTS.

2 WIND LOAD ZONE DIAGRAMS

FRAMING NOTES

- FOR GENERAL NOTES SEE SHEET S1.1 AND S1.2
- FOR TYPICAL DETAILS SEE SHEET S1.3 AND S1.4
- DIMENSIONS ARE SHOWN FOR GENERAL INFORMATION. COORDINATE WITH ARCHITECTURAL PLANS
- SEE ARCHITECTURAL ROOF PLAN FOR ROOF HATCHES.
- DESIGN JOISTS UNDER UNITS WITH LOADS INDICATED ON THE DRAWINGS. STEEL JOIST MANUFACTURER TO PROVIDE STEEL JOIST SIZE (MAX JOIST DEPTH TO BE AS SHOWN ON PLANS) DESIGN JOIST FOR 1600. (MECHANICAL WEIGHT + DEAD LOAD ONLY) COORDINATE OPENINGS WITH MECHANICAL PLANS
- JOIST MANUFACTURER TO VERIFY THE MINIMUM ROW OF BRIDGING AND BRIDGING SIZE, AS REQUIRED BY SJI.
- STEEL BEAM TO STEEL COLUMN CONNECTION PER DETAIL: 15 S1.3
- STEEL BEAM TO STEEL BEAM CONNECTION PER DETAIL: 16 S1.3
- ALL STEEL COLUMN SHALL BE HSS 4x4x1/4 U.N.O. ON PLANS
- WHERE STEEL JOIST IS SUPPORTED BY A STEEL COLUMN, SEE DETAIL: 18 S1.3
- FOR OPENING IN ROOF AND AT MECHANICAL UNITS, SEE DETAIL: 20 S1.3
- INDICATES 12" CMU WALL (2) #6 (V) AT 48" AND (2) #6 (H) AT 48" O.C. U.N.O. VERIFY CMU WALLS THICKNESS WITH ARCHITECTURAL PLANS. 12" WALLS SHOWN ON STRUCTURAL PLANS ARE MINIMUM THICKNESS AND GOVERN OVER ARCHITECTURAL DRAWINGS.
- INDICATES 8" CMU WALL w/ (1) #6 (V) AT 48" AND (1) #6 (H) AT 48" O.C. U.N.O. VERIFY CMU WALLS THICKNESS WITH ARCHITECTURAL PLANS. 8" WALLS SHOWN ON STRUCTURAL PLANS ARE MINIMUM THICKNESS AND GOVERN OVER ARCHITECTURAL DRAWINGS.
- INDICATES CMU LINTEL (NOT ALL LINTELS ARE SHOWN). SEE DETAIL: 11 S1.4
- PROVIDE CMU LINTEL WHERE MECH. DUCT PENETRATES CMU WALL. PER DETAIL: 16 S1.4
- STEEL BEAM TO CMU WALL CONNECTION PER DETAIL, U.N.O. 17 S1.4
- WHERE STEEL JOIST IS SUPPORTED BY A STEEL BEAM, SEE DETAIL: 17 S1.3
- FOR CMU WALLS EXTENDING TO THE UNDERSIDE OF ROOF DECK, SEE DETAIL: 14 20 S5.1
- ALL STEEL EXPOSED TO WEATHER SHALL BE HOT DIP GALVANIZED.
- FOR CMU WALL BRACE TO ROOF STRUCTURE SEE DETAILS: 7 8 S1.4

BASE BID
 FRAMING PLAN
 1/8" = 1'-0"

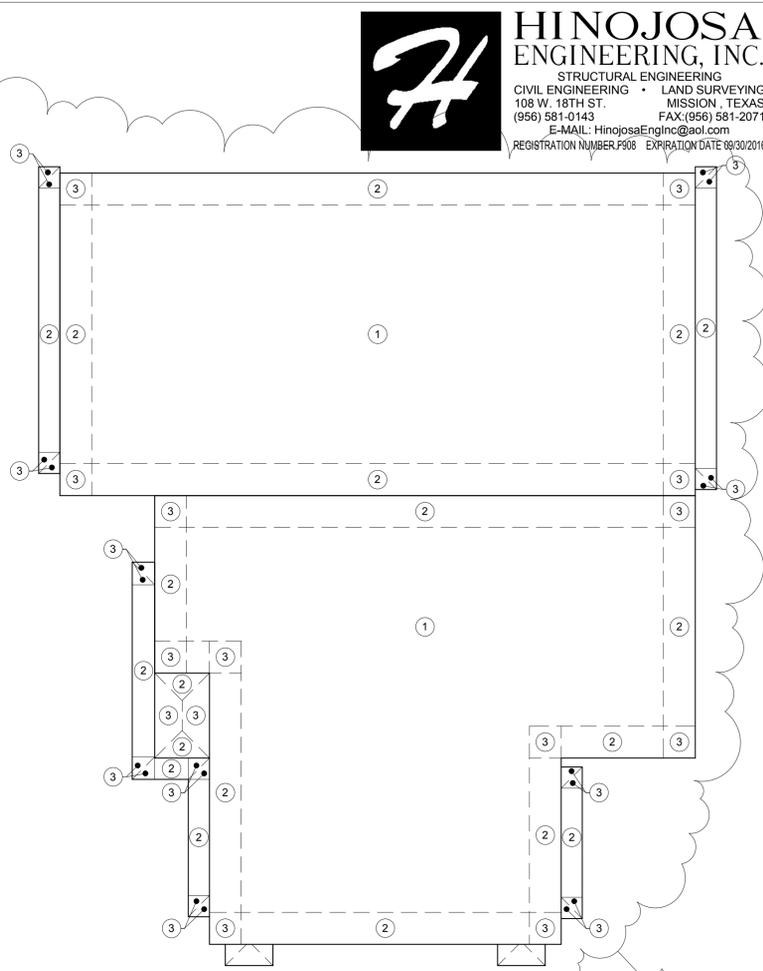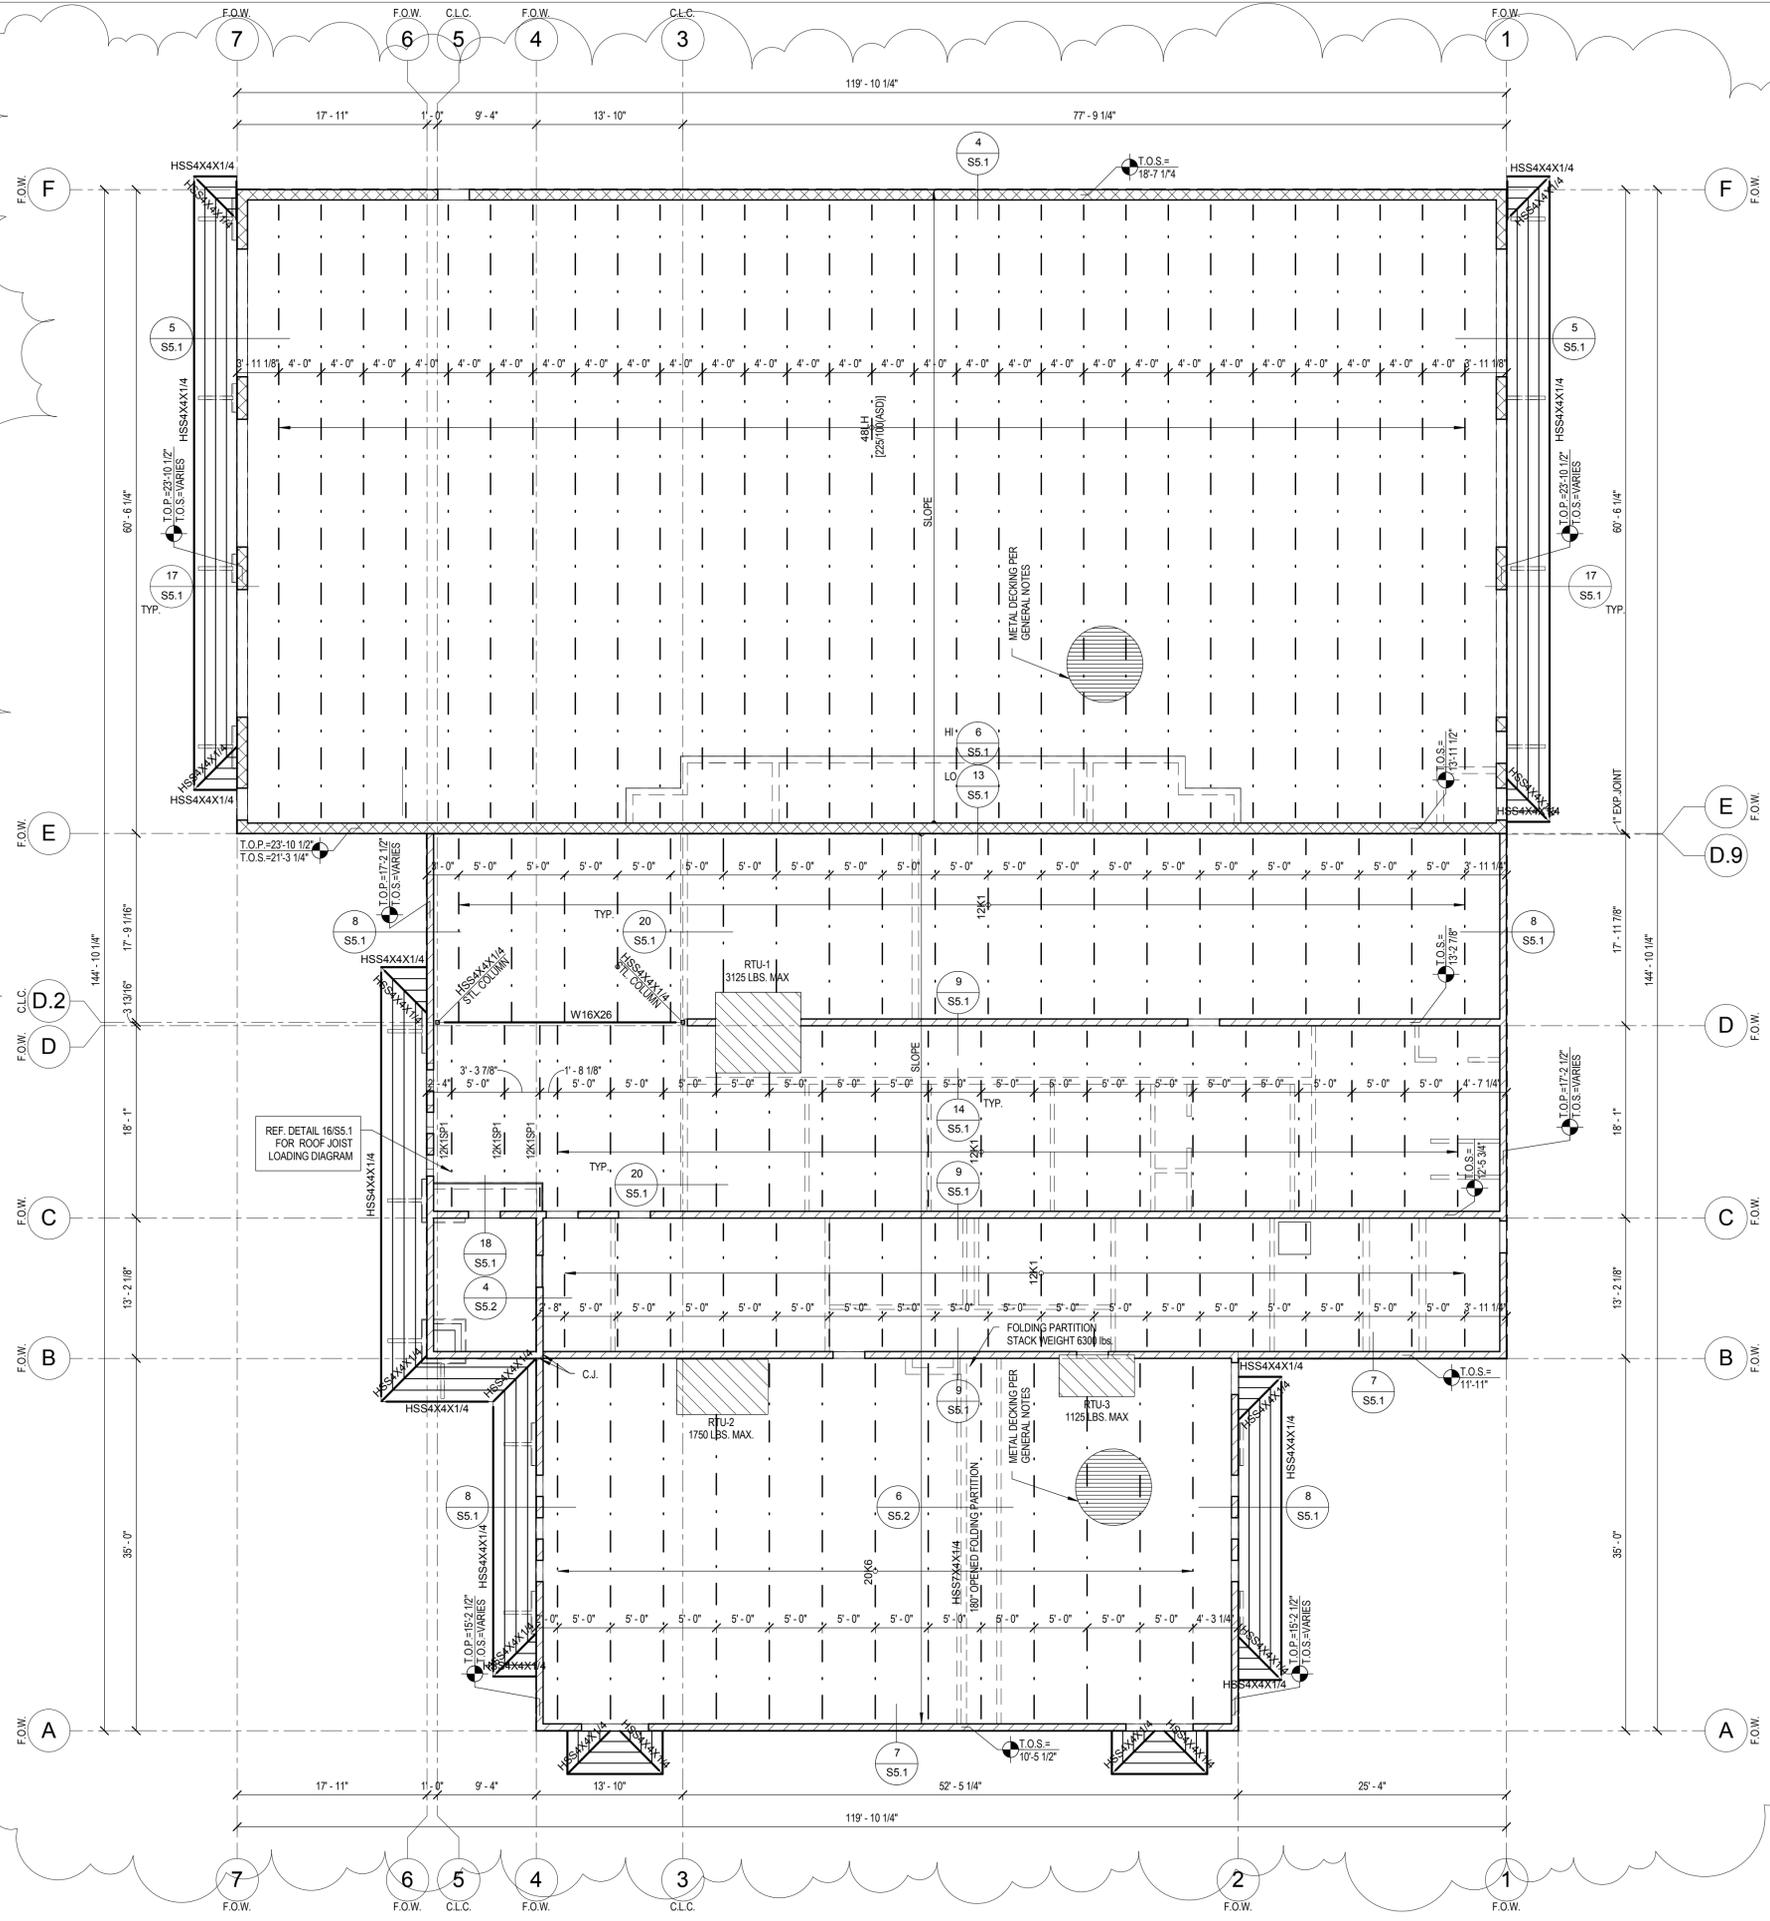

ROOF COMPONENT AND CLADDING GROSS WIND PRESSURES

ROOF ZONE	TRIBUTARY AREA					
	10 SF.	20 SF.	50 SF.	100 SF.	200 SF.	500 SF.
#1 INTERM.	+18.6	-45.6	+17.4	-44.5	+15.9	-42.9
#2 EDGE	+18.6	-76.6	+17.4	-68.4	+15.9	-57.6
#3 CORN.	+18.6	-115.2	+17.4	-95.4	+15.9	-69.3


(+) INDICATES AN UPWARD DIRECTION
 *WIND PRESSURES SHOWN ARE GROSS VALUES USING LOAD RESISTANCE FACTOR DESIGN (LRFD).
 *NET UPLIFT IS THE GROSS UPLIFT MINUS THE ALLOWABLE PORTION OF DEAD LOAD INCLUDING THE WEIGHT OF THE JOIST.
 *EDGE DISTANT (a)=8 ft.
 *ALLOWABLE PORTION OF DEAD LOAD TO BE SUBTRACTED FROM GROSS UPLIFT= 10 PSF.
 *ULTIMATE DESIGN WIND SPEED= 140 MPH.
 1. DOORS & WINDOWS MAXIMUM DESIGN WIND PRESSURES:
 P+ = +45.6 TOWARDS THE SURFACE.
 P- = -61.1 AWAY FROM THE SURFACE.
 2. THE STRUCTURE IS DESIGNED TO MEET ASCE 7-10 WIND PRESSURES. ALL COMPONENTS AND CLADDING (EX. WINDOWS, DOORS, RTUS AND ARCHITECTURAL COPING AND ROOFING MATERIALS), SHALL MEET MINIMUM CODE REQUIREMENTS.

2 WIND LOAD ZONE DIAGRAMS


FRAMING NOTES

- FOR GENERAL NOTES SEE SHEET S1.1 AND S1.2
- FOR TYPICAL DETAILS SEE SHEET S1.3 AND S1.4
- DIMENSIONS ARE SHOWN FOR GENERAL INFORMATION. COORDINATE WITH ARCHITECTURAL PLANS.
- SEE ARCHITECTURAL ROOF PLAN FOR ROOF HATCHES.
- DESIGN JOISTS UNDER UNITS WITH LOADS INDICATED ON THE DRAWINGS. STEEL JOIST MANUFACTURER TO PROVIDE STEEL JOIST SIZE (MAX JOIST DEPTH TO BE AS SHOWN ON PLANS) DESIGN JOIST FOR 1600. (MECHANICAL WEIGHT + DEAD LOAD ONLY) COORDINATE OPENINGS WITH MECHANICAL PLANS.
- JOIST MANUFACTURER TO VERIFY THE MINIMUM ROW OF BRIDGING AND BRIDGING SIZE, AS REQUIRED BY SJI.
- STEEL BEAM TO STEEL COLUMN CONNECTION PER DETAIL: 15 | S1.3
- STEEL BEAM TO STEEL BEAM CONNECTION PER DETAIL: 16 | S1.3
- ALL STEEL COLUMN SHALL BE HSS 5x5x1/4 U.N.O. ON PLANS.
- WHERE STEEL JOIST IS SUPPORTED BY A STEEL COLUMN, SEE DETAIL: 18 | S1.3
- FOR OPENING IN ROOF AND AT MECHANICAL UNITS, SEE DETAIL: 20 | S1.3
- INDICATES 12" CMU WALL (2) #6 (V) AT 48" AND (2) #5 (H) AT 48" O.C. U.N.O. VERIFY CMU WALLS THICKNESS WITH ARCHITECTURAL PLANS. 12" WALLS SHOWN ON STRUCTURAL PLANS ARE MINIMUM THICKNESS AND GOVERN OVER ARCHITECTURAL DRAWINGS.
- INDICATES 8" CMU WALL w/ (1) #6 (V) AT 48" AND (1) #5 (H) AT 48" O.C. U.N.O. VERIFY CMU WALLS THICKNESS WITH ARCHITECTURAL PLANS. 8" WALLS SHOWN ON STRUCTURAL PLANS ARE MINIMUM THICKNESS AND GOVERN OVER ARCHITECTURAL DRAWINGS.
- INDICATES CMU LINTEL (NOT ALL LINTELS ARE SHOWN), SEE DETAIL: 11 | S1.4
- PROVIDE CMU LINTEL WHERE MECH. DUCT PENETRATES CMU WALL, PER DETAIL: 16 | S1.4
- STEEL BEAM TO CMU WALL CONNECTION PER DETAIL, U.N.O. 17 | S1.4
- WHERE STEEL JOIST IS SUPPORTED BY A STEEL BEAM, SEE DETAIL: 17 | S1.3
- FOR CMU WALLS EXTENDING TO THE UNDERSIDE OF ROOF DECK, SEE DETAIL: 14 | 20 | S5.1
- ALL STEEL EXPOSED TO WEATHER SHALL BE HOT DIP GALVANIZED.
- FOR CMU WALL BRACE TO ROOF STRUCTURE SEE DETAILS: 7 | 8 | S1.4


ALTERNATE #3
 FRAMING PLAN
 1/8" = 1'-0"

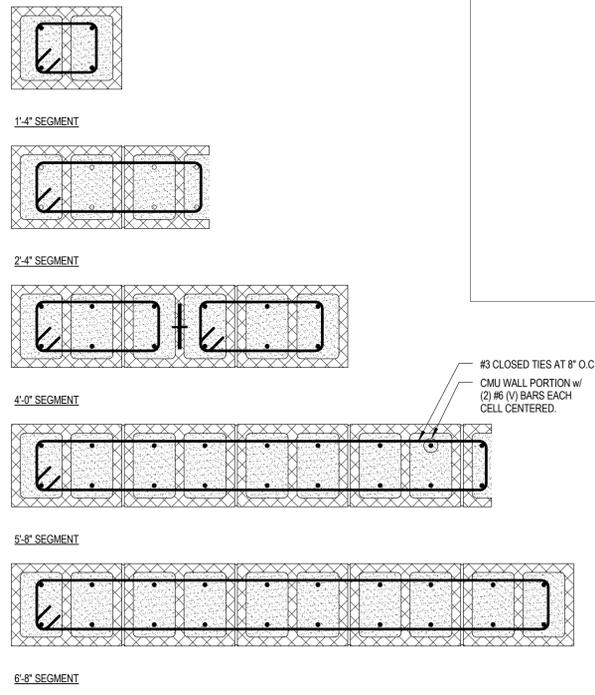


18 12" WALL SEGMENTS

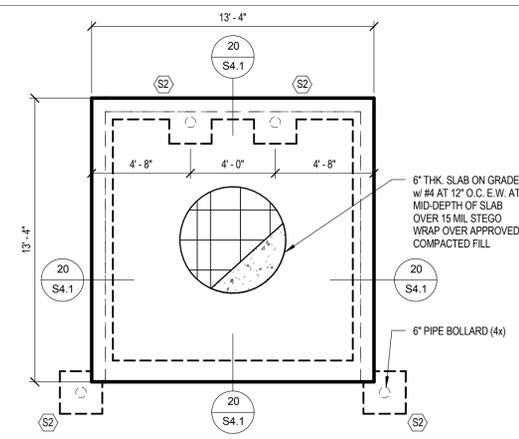


2 DUMPSTER ENCLOSURE FOUNDATION PLAN
1/4" = 1'-0"

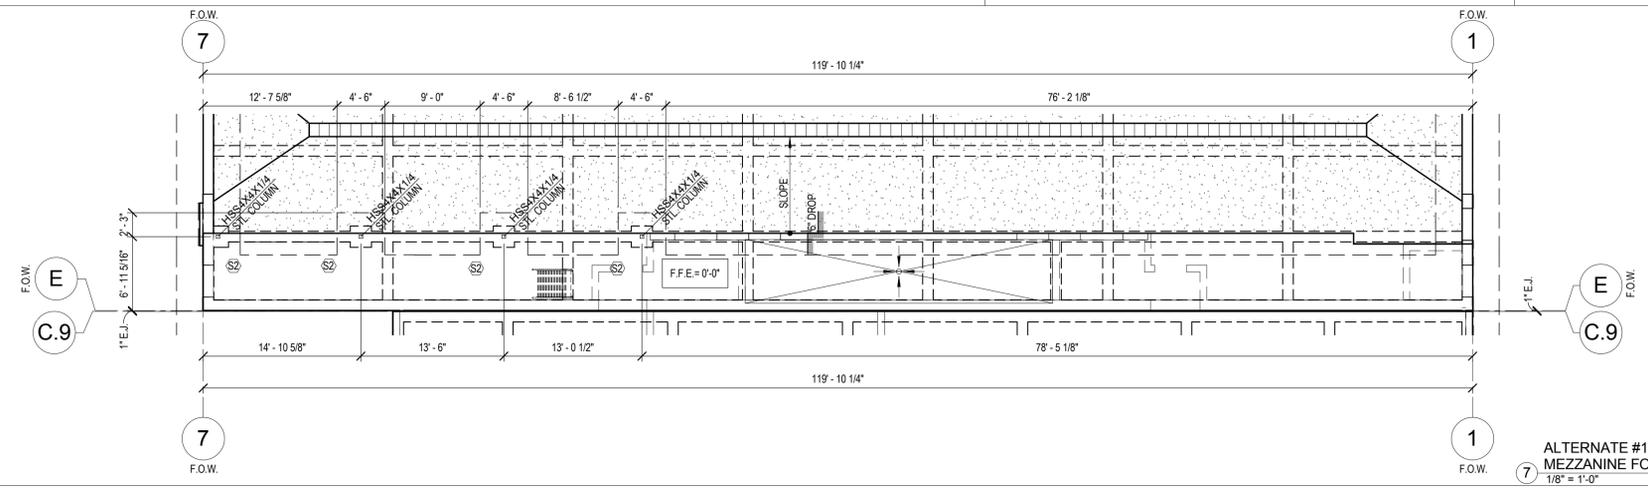

7 ALTERNATE #1 MEZZANINE FOUNDATION PLAN
1/8" = 1'-0"

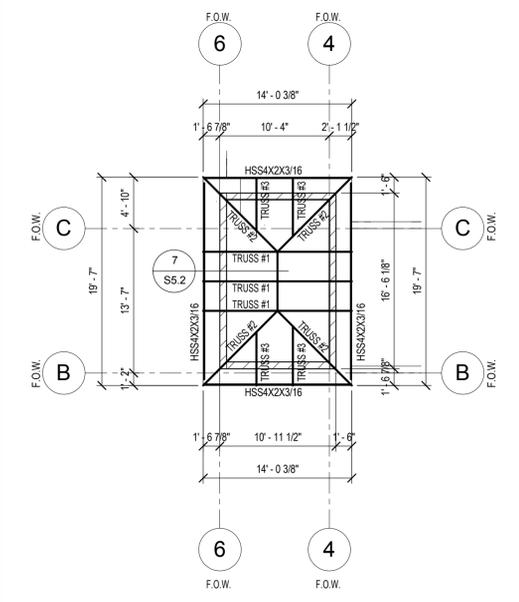

4 HIGH TOWER FRAMING PLAN
1/8" = 1'-0"

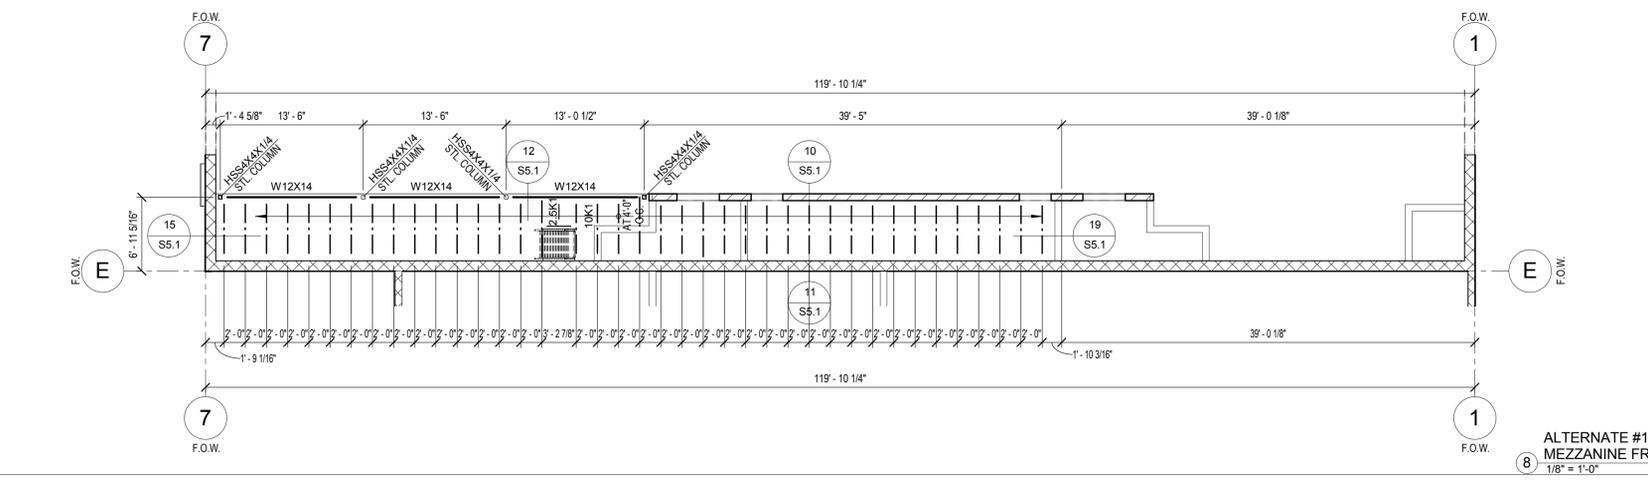

8 ALTERNATE #1 MEZZANINE FRAMING PLAN
1/8" = 1'-0"


EDINBURG FIRE STATION #5
 CITY OF EDINBURG
 JASMAN RD & FM2812

PROJECT NUMBER 15-118
 DATE 09-16-15
 ADDENDUM #1 01-17-16

S H E E T
 STRUCTURAL
 FRAMING PLAN


FOOTING SCHEDULE					
TYPE	A	B	C	D	REINFORCING
S2	2'-0"			3'-0"	#5'S @ 10" O.C. E.W TOP & BOT.
S4	4'-0"			3'-0"	#5'S @ 10" O.C. E.W TOP & BOT.
S7	7'-0"			3'-0"	#5'S @ 10" O.C. E.W TOP & BOT.
SS	5'-0"			3'-0"	#5'S @ 10" O.C. E.W TOP & BOT.

- NOTES:
 1. D = FOOTING DEPTH BELOW FINISH FLOOR.
 2. FOOTING DIMENSIONS ARE FOR BIDDING PURPOSES ONLY. ACTUAL DIMENSION MAY VARY.
 3. PROVIDE UNIT PRICES (ON A CUBIC YARD BASIS) FOR REINFORCED (#5'S @ 12" O.C. E.W. TOP & BOT.) WIDENED BEAM CONCRETE FOOTINGS.

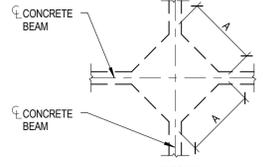

WIDENED BEAM FOOTINGS


17 FOOTING SCHEDULE

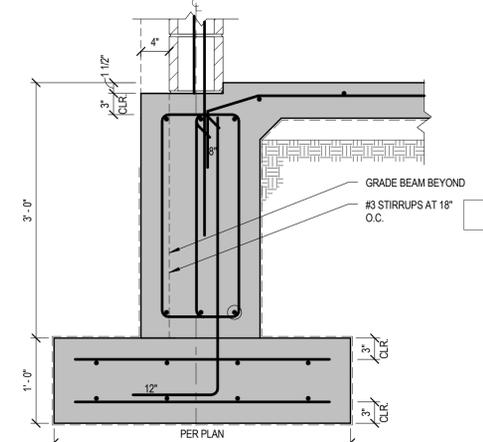

18 EXTERIOR GRADE BEAM AT BRICK VENEER

FOR ADDITIONAL INFO SEE DETAIL S4.1


13 EXTERIOR GRADE BEAM

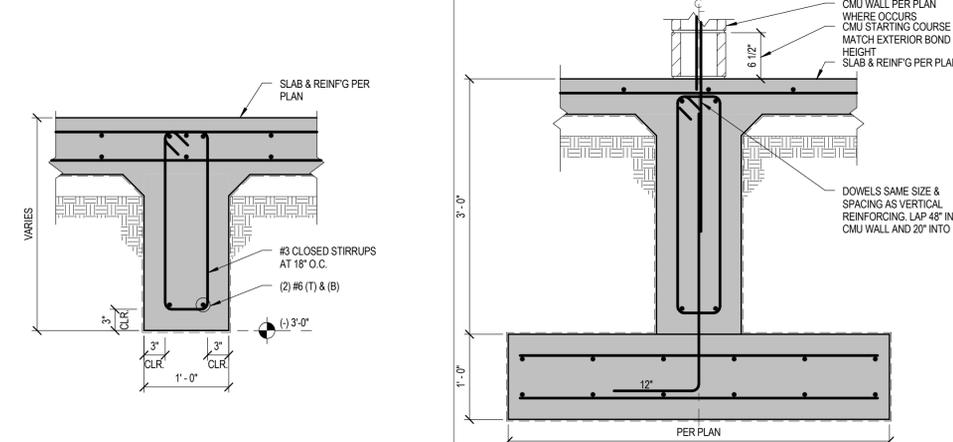

14 INTERIOR GRADE BEAM

FOR ADDITIONAL INFO SEE DETAIL S4.1

10 INTERIOR GRADE BEAM

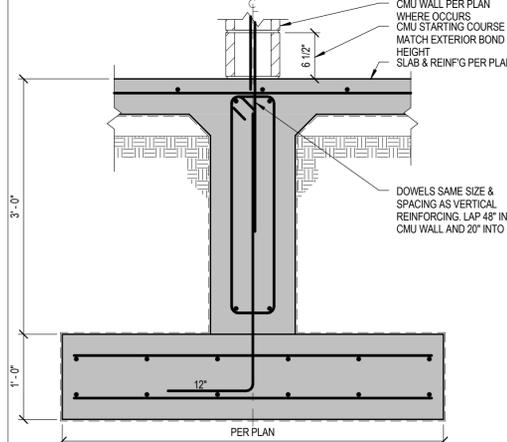

11 EXTERIOR GRADE BEAM AT OPENING

FOR ADDITIONAL INFO SEE DETAIL S4.1


5 INTERIOR GRADE BEAM



2 EXTERIOR GRADE BEAM

FOR ADDITIONAL INFO SEE DETAIL S4.1


2 EXTERIOR GRADE BEAM

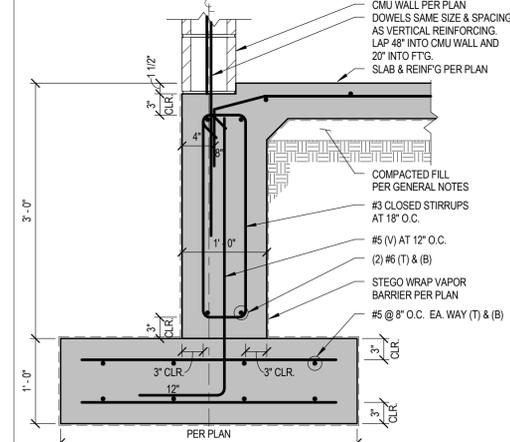

7 FOUNDATION DETAIL


FOR ADDITIONAL INFO SEE DETAIL S4.1

20 WALL SECTION

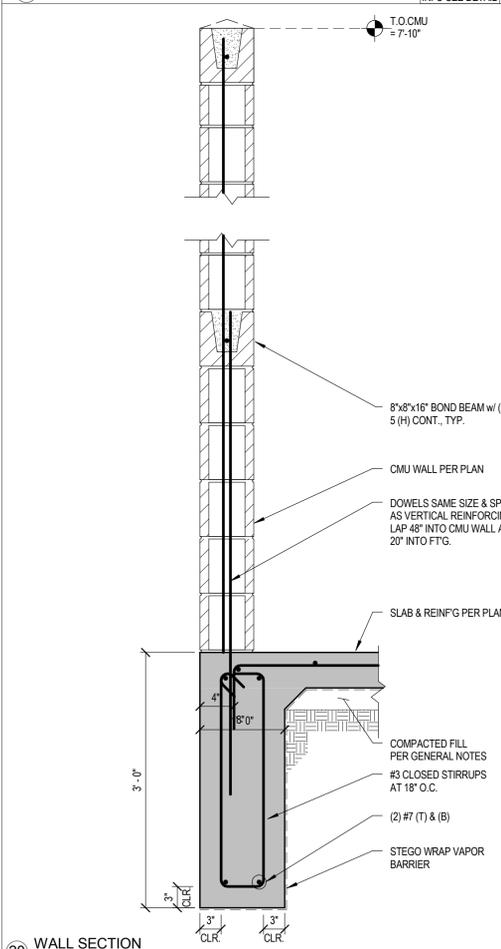

20 WALL SECTION


15 FOUNDATION DETAIL

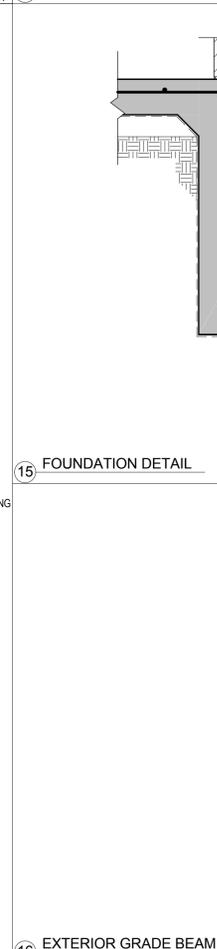

16 EXTERIOR GRADE BEAM AT BRICK VENEER

FOR ADDITIONAL INFO SEE DETAIL S4.1


11 EXTERIOR GRADE BEAM AT OPENING

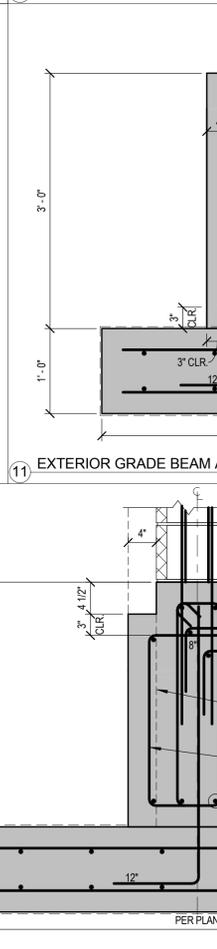

8 EXTERIOR GRADE BEAM

FOR ADDITIONAL INFO SEE DETAIL S4.1


8 EXTERIOR GRADE BEAM

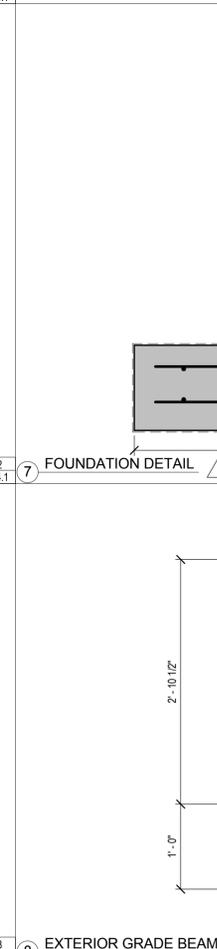

8 EXTERIOR GRADE BEAM

FOR ADDITIONAL INFO SEE DETAIL S4.1

7 FOUNDATION DETAIL

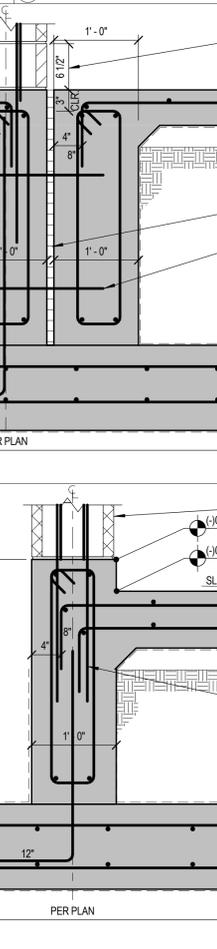

8 EXTERIOR GRADE BEAM



HINOJOSA ENGINEERING, INC.
 STRUCTURAL ENGINEERING
 CIVIL ENGINEERING • LAND SURVEYING
 108 W. 18TH ST. MISSION, TEXAS
 (956) 581-0143 FAX: (956) 581-2071
 E-MAIL: HinojosaEngInc@aol.com
 REGISTRATION NUMBER F908 EXPIRATION DATE 09/30/2016



EDINBURG FIRE STATION #5
 CITY OF EDINBURG
 JASMAN RD & FM2812

PROJECT NUMBER 15-118
 DATE 09-16-15
 ADDENDUM #1 01-17-16

S H E E T
 STRUCTURAL FOUNDATION DETAILS

S4.1




HINOJOSA ENGINEERING, INC.
 STRUCTURAL ENGINEERING
 CIVIL ENGINEERING • LAND SURVEYING
 108 W. 18TH ST. MISSION, TEXAS
 (956) 581-0143 FAX: (956) 581-2071
 E-MAIL: HinojosaEngInc@aol.com
 REGISTRATION NUMBER F908 EXPIRATION DATE 09/30/2016




Milnet
 Architectural
 Services

AMERICAN INSTITUTE OF ARCHITECTS


EDINBURG FIRE STATION #5
 CITY OF EDINBURG
 JASMAN RD & FM2812

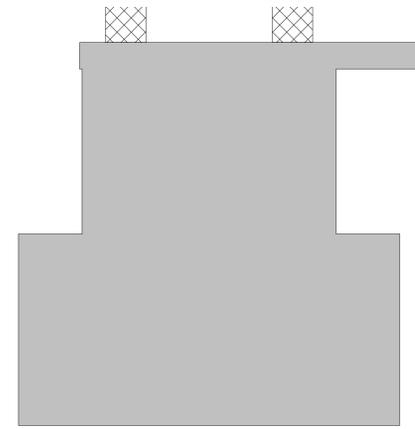


5 FOUNDATION DETAIL

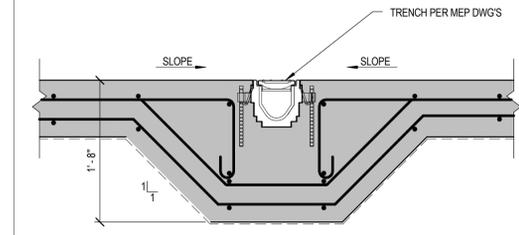

2 TRENCH DETAIL

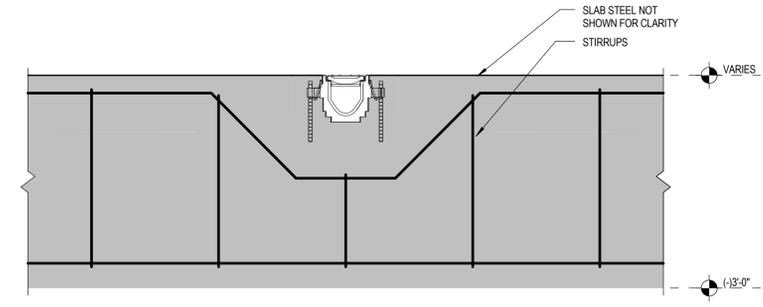

7 INT. GRADE BEAM AT TRENCH

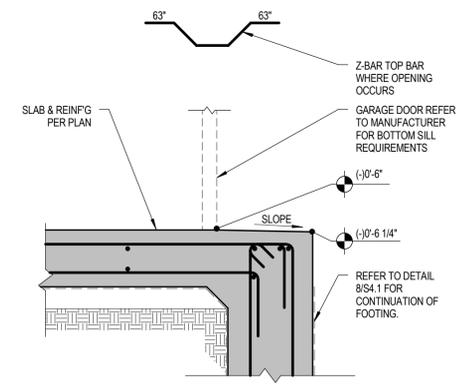

4 FOOTING AT GARAGE DOOR

FOR ADDITIONAL 8
 INFO SEE DETAIL S4.1


EDINBURG FIRE STATION #5

CITY OF EDINBURG
 JASMAN RD & FM2812


PROJECT NUMBER 15-118
 DATE 09-16-15
 ADDENDUM #1 01-17-16

S H E E T
 STRUCTURAL
 FOUNDATION DETAILS


S4.2

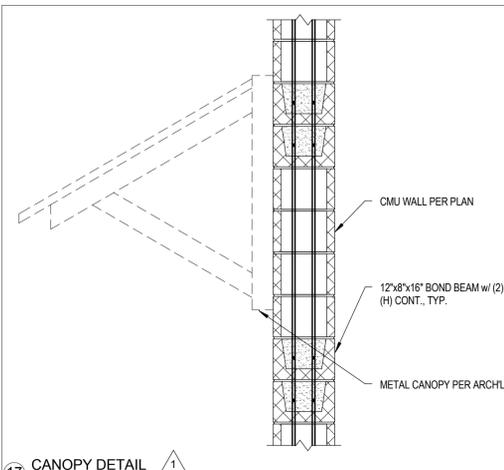


17 CANOPY DETAIL

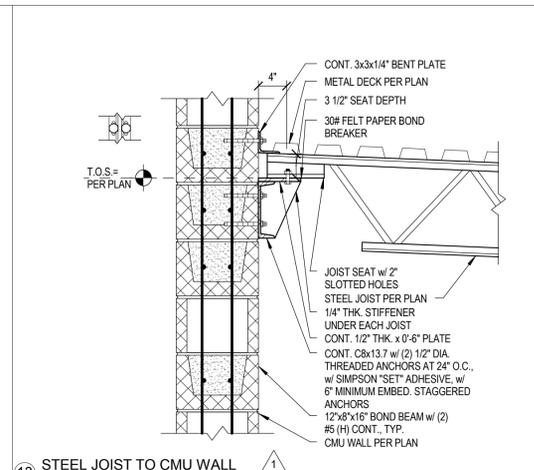


13 STEEL JOIST TO CMU WALL

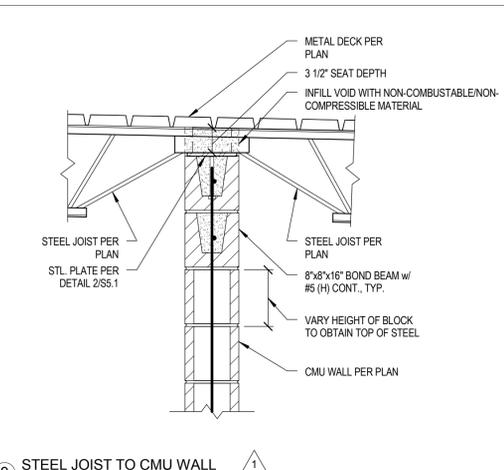


9 STEEL JOIST TO CMU WALL

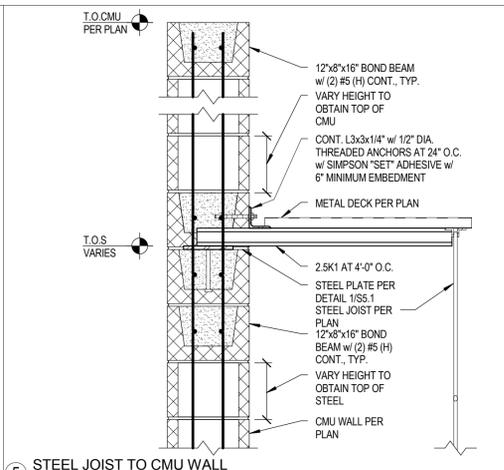


5 STEEL JOIST TO CMU WALL

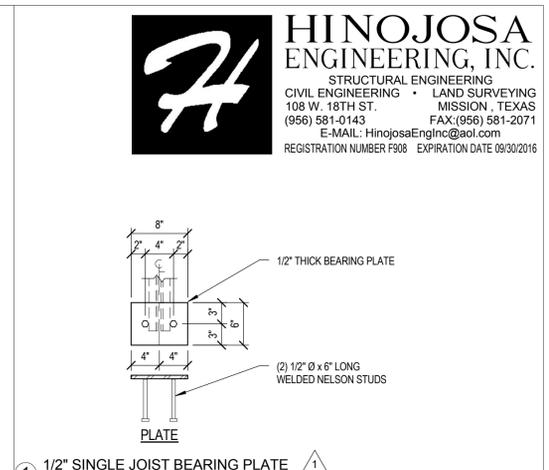


1 1/2" SINGLE JOIST BEARING PLATE

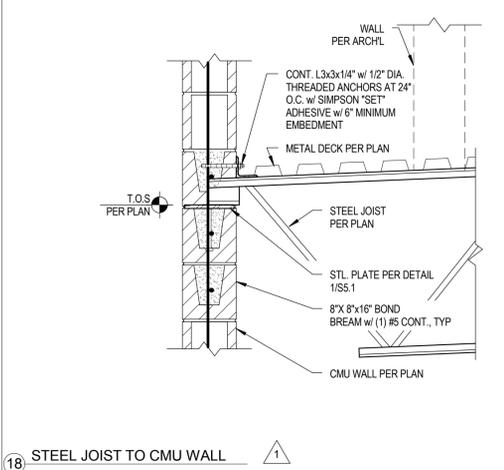


18 STEEL JOIST TO CMU WALL

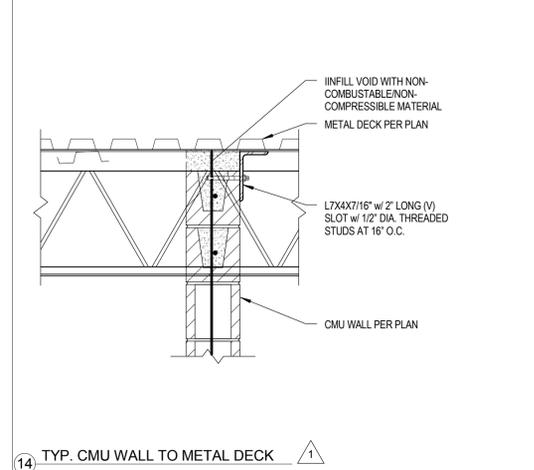


14 TYP. CMU WALL TO METAL DECK

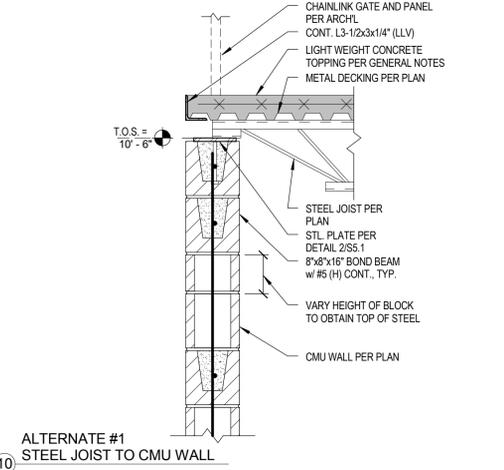


ALTERNATE #1 STEEL JOIST TO CMU WALL

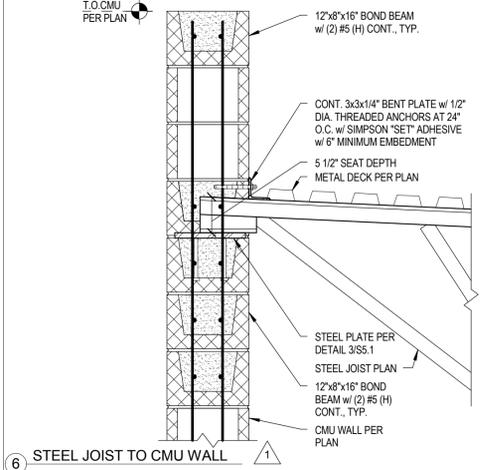


6 STEEL JOIST TO CMU WALL

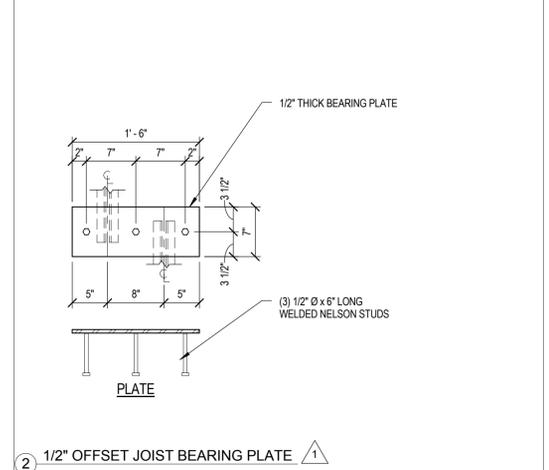


1 1/2" OFFSET JOIST BEARING PLATE

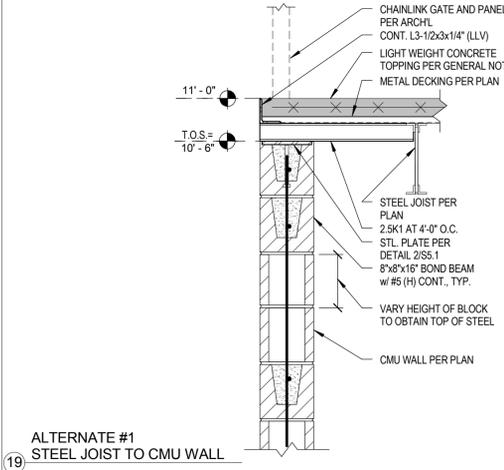


ALTERNATE #1 STEEL JOIST TO CMU WALL

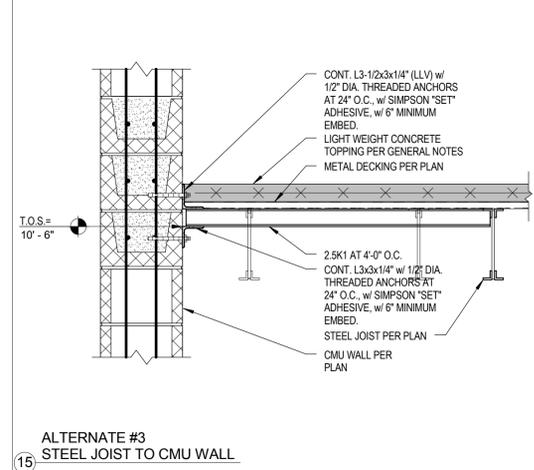


ALTERNATE #3 STEEL JOIST TO CMU WALL

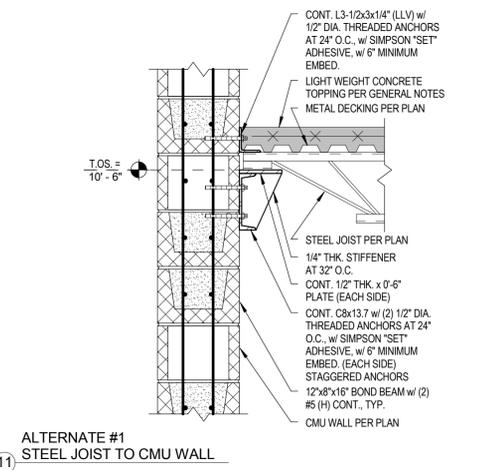


ALTERNATE #1 STEEL JOIST TO CMU WALL

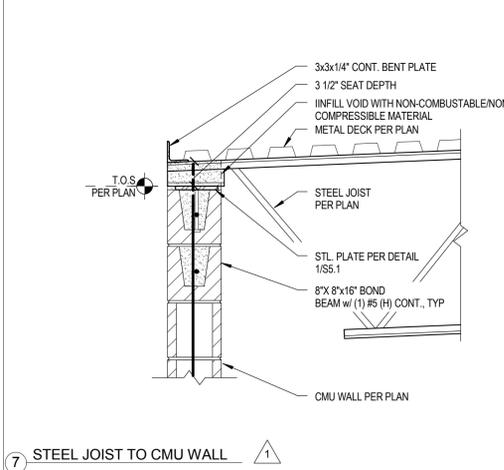


7 STEEL JOIST TO CMU WALL

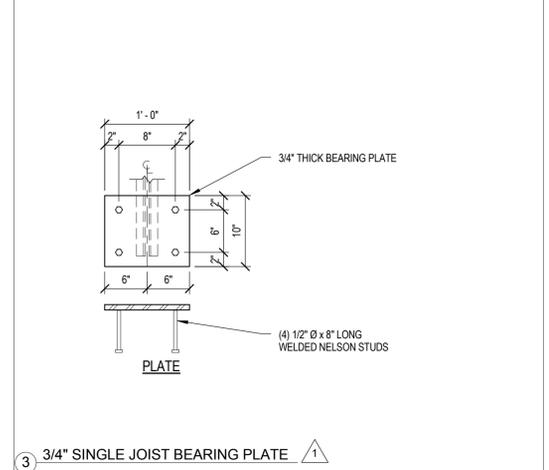


3 3/4" SINGLE JOIST BEARING PLATE

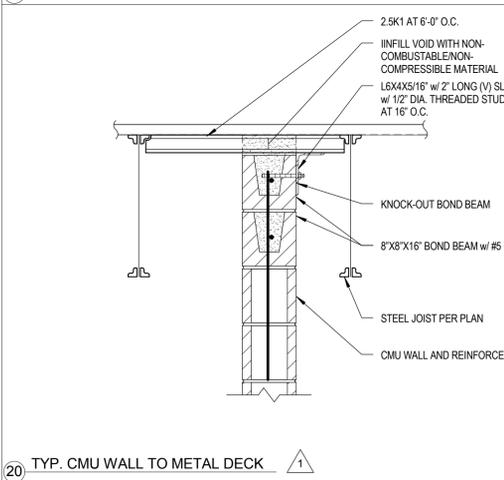


20 TYP. CMU WALL TO METAL DECK

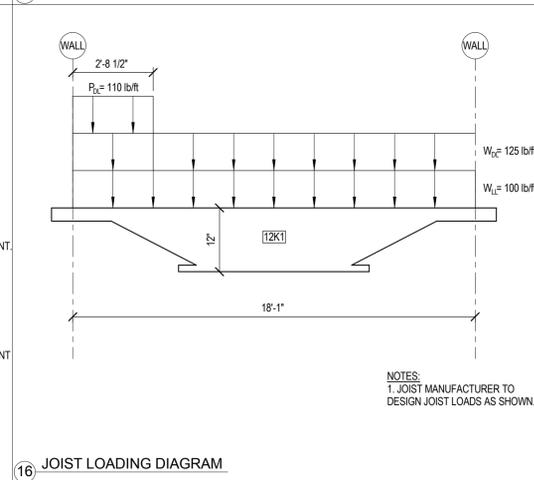



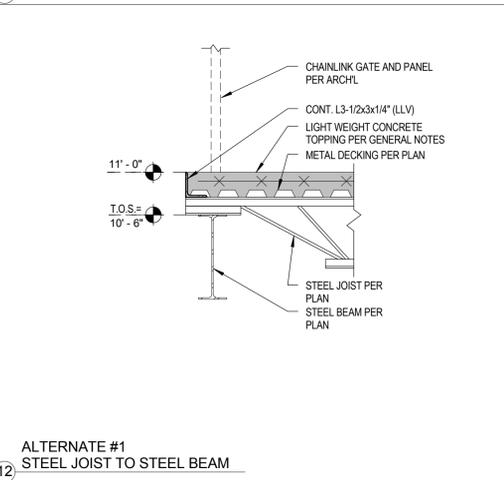

ALTERNATE #1 STEEL JOIST TO STEEL BEAM

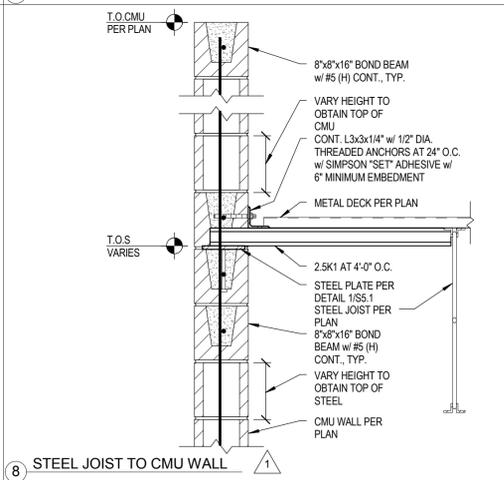

8 STEEL JOIST TO CMU WALL

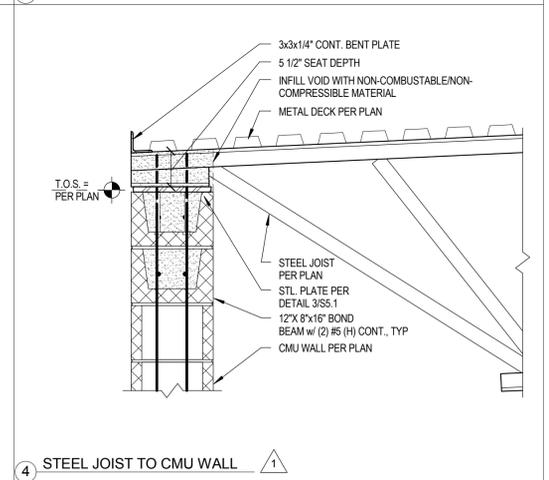

4 STEEL JOIST TO CMU WALL



EDINBURG FIRE STATION #5
CITY OF EDINBURG
JASMAN RD & FM2812

PROJECT NUMBER
15-118
DATE
09-16-15
ADDENDUM #1
01-17-16

S H E E T
STRUCTURAL
FRAMING DETAILS

S5.1



HINOJOSA ENGINEERING, INC.
 STRUCTURAL ENGINEERING • LAND SURVEYING
 CIVIL ENGINEERING • MISSION, TEXAS
 108 W. 18TH ST. MISSION, TEXAS
 (956) 581-0143 FAX: (956) 581-2071
 E-MAIL: HinojosaEngInc@aol.com
 REGISTRATION NUMBER F908 EXPIRATION DATE 09/30/2016



Milnet
 Architectural
 Services

AMERICAN INSTITUTE OF ARCHITECTS



EDINBURG FIRE STATION #5

CITY OF EDINBURG

JASMAN RD & FM2812

PROJECT NUMBER
 15-118


DATE
 09-16-15

ADDENDUM #1
 01-17-16


S H E E T

STRUCTURAL
 FRAMING DETAILS


S5.2

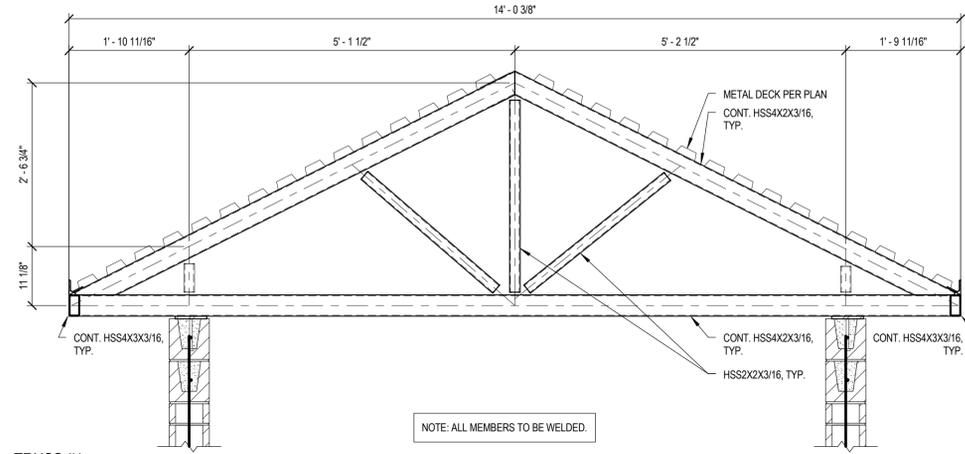


13 TRUSS #1

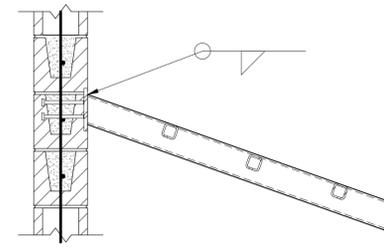


5 CANOPY DETAIL

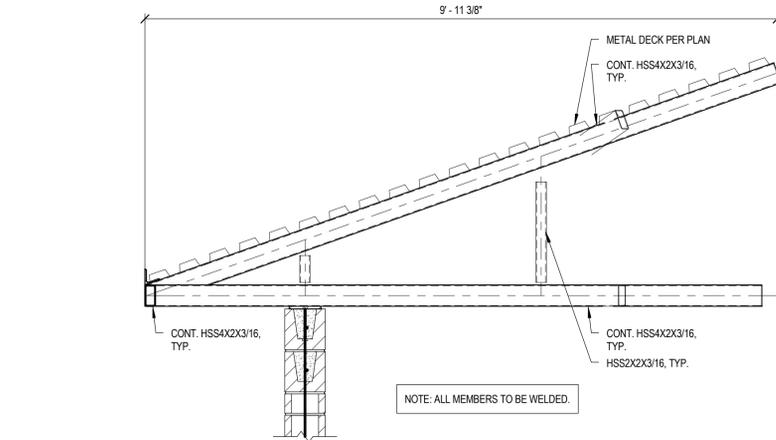


14 TRUSS #2

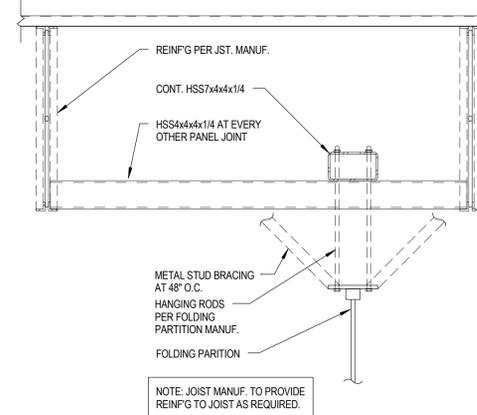


6 FOLDING PARTITION SUPPORT

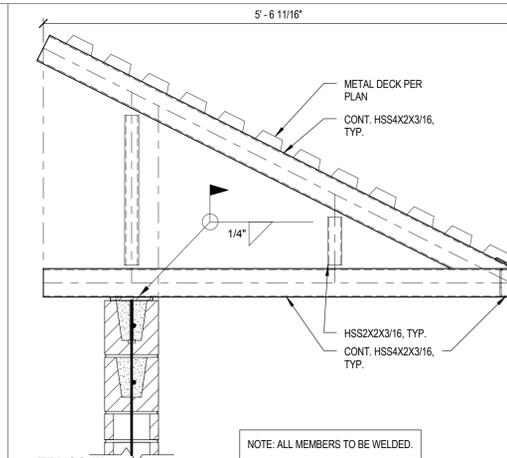

12 TRUSS #3

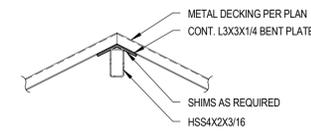

7 TYP. HIGH TOWER HIP/RIDE DETAIL

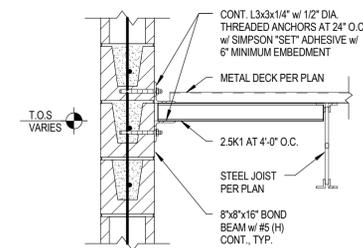

4 FRAMING SECTION

Addendum

DATE

January 7, 2016

ADDENDUM NO. 1

PROJECT 14815.000 | Edinburg Fire Station #5

The work described herein shall be added to the scope of work defined by the contract documents or it shall modify the scope of work defined by the contract documents as described. This work shall become a part of the contract documents by addendum.

DRAWINGS

Item 01

Sheet M2.1

- A. Mechanical plan shows complete drawings including all alternates.
- B. For base bid in bay area, third bay was removed. Shift all equipment to fit in two bays. Remove 2 Airvac units, for two bay in lieu of 3 bays. Remove gas heaters number 5 and 6.
- C. Remove FPB-10 and associated ductwork and grills and make FPB-9 725 cfm in lieu of 500. Add a supply diffuser to the entry corridor and balance it to 75 cfm. Also extend the ductwork to new location of supply room and add a supply diffuser balanced to 100 cfm. Readjust the dustless mini-split and condensing unit as well.
- D. Resize and relocate the condensate drain lines to new location of room 109.
- E. Mechanical drawing show complete drawing including alternate 3. Alternate three is including the community rooms. For base bid remove rooftop units, ductwork, grilles and controls serving the community rooms only.
- F. For base bid remove exhaust fan number 4 and everything associated with it.

Item 02

Sheet EL2.1

- A. Lighting plan shown is to be provided as part of Alternate #4. Base bid plan shall have two (2) bays in Garage #124 in lieu of the three (3) shown. For base bid remove one row of type 'A2' light fixtures connected to circuit LB-1 and rearrange the remaining fixtures for adequate coverage. Remove associated lighting controls for fixtures removed.
- B. For base bid remove two (2) type 'WP' exterior wall pack fixtures, one at west side and one at east side as required for two bays instead of three.

Item 03

Sheet EP2.1

- A. Power plan shown is to be provided as part of Alternate #4. Base bid plan shall have two (2) bays in Garage #124 in lieu of the three (3) shown. For base bid remove electrical items associated with the additional bay including: electrical circuit and controls for overhead doors, electrical receptacles at east and west walls and all electrical associated with any mechanical items to be removed.

Item 04

Sheet MEP2.1 – MEP Site Plan

- A. Alternate #2 – Wash Area - Route 2" domestic water up and stub up with 2" threaded fitting. Re: MEP2.1.
- B. Alternate # 2 – Wash Area – Provide catch basin CB-1 at wash area. Provide catch basin type "CC" inlet with junction box lid. Re: MEP2.1 and detail 6/P4.3.
- C. Remove one type H2 light fixture referred to in electrical keynote #13 for a total of two (2) type H2 light fixtures.

Item 05

Sheet P2.1 – Plumbing Floor Plan

- A. Provide TP-2 for FD-1 at ESEW-1 and FD-1 at air compressor.


Addendum No.

- B. If Alternate # 1 is not accepted, locate air compressor and 3"FD-1 in Garage Area floor.
- C. Alternate #2 – Wash Area –Provide 2" domestic water from 2" line in Garage area and route below ground and route to remote wash area. Refer to attached P2.1 and MEP2.1 for continuation.
- D. Alternate #2 – Wash Area - Route 6" oil waste line from wash area to oil/sand/mud interceptor. If Alternate # 2 is accepted upsize OSM-1 to model SOCMP-1000 capacity in lieu of 750 and upsize sanitary sewer piping to 6". Refer to attached P2.1 and MEP2.1.
- E. Base Bid – Omit all utilities and plumbing fixtures (CW,HW, sanitary waste & vent) serving Women 105 and Men 106, EDF-1 in Vestibule 104 and SK-1 in Kitchen 107. Refer to architectural base bid plans.
- F. Base Bid – Locate EWH-1 and all associated plumbing equipment/fixtures to new location of Elec.109 including domestic water entry and wall hydrant on east wall of Elec.109. Route sanitary to nearest sanitary in Corridor 113. Refer to architectural base bid plans.
- G. Base Bid – Omit TD-1 where third bay was located and locate all WH-1 on exterior wall, VTRs, and all 2"CW for "quick filling" of fire trucks to new wall of two bay floor plan. Omit gas supply to unit heaters at third bay. Gas demand in building to 438CFH. Refer to architectural base bid plans.

Item 06**Sheet P4.1 – Plumbing Schedules**


- A. WC-1/WC-2 provide exposed electronic battery powered sensor activated flush valve omit dual flush note.

END OF ADDENDUM

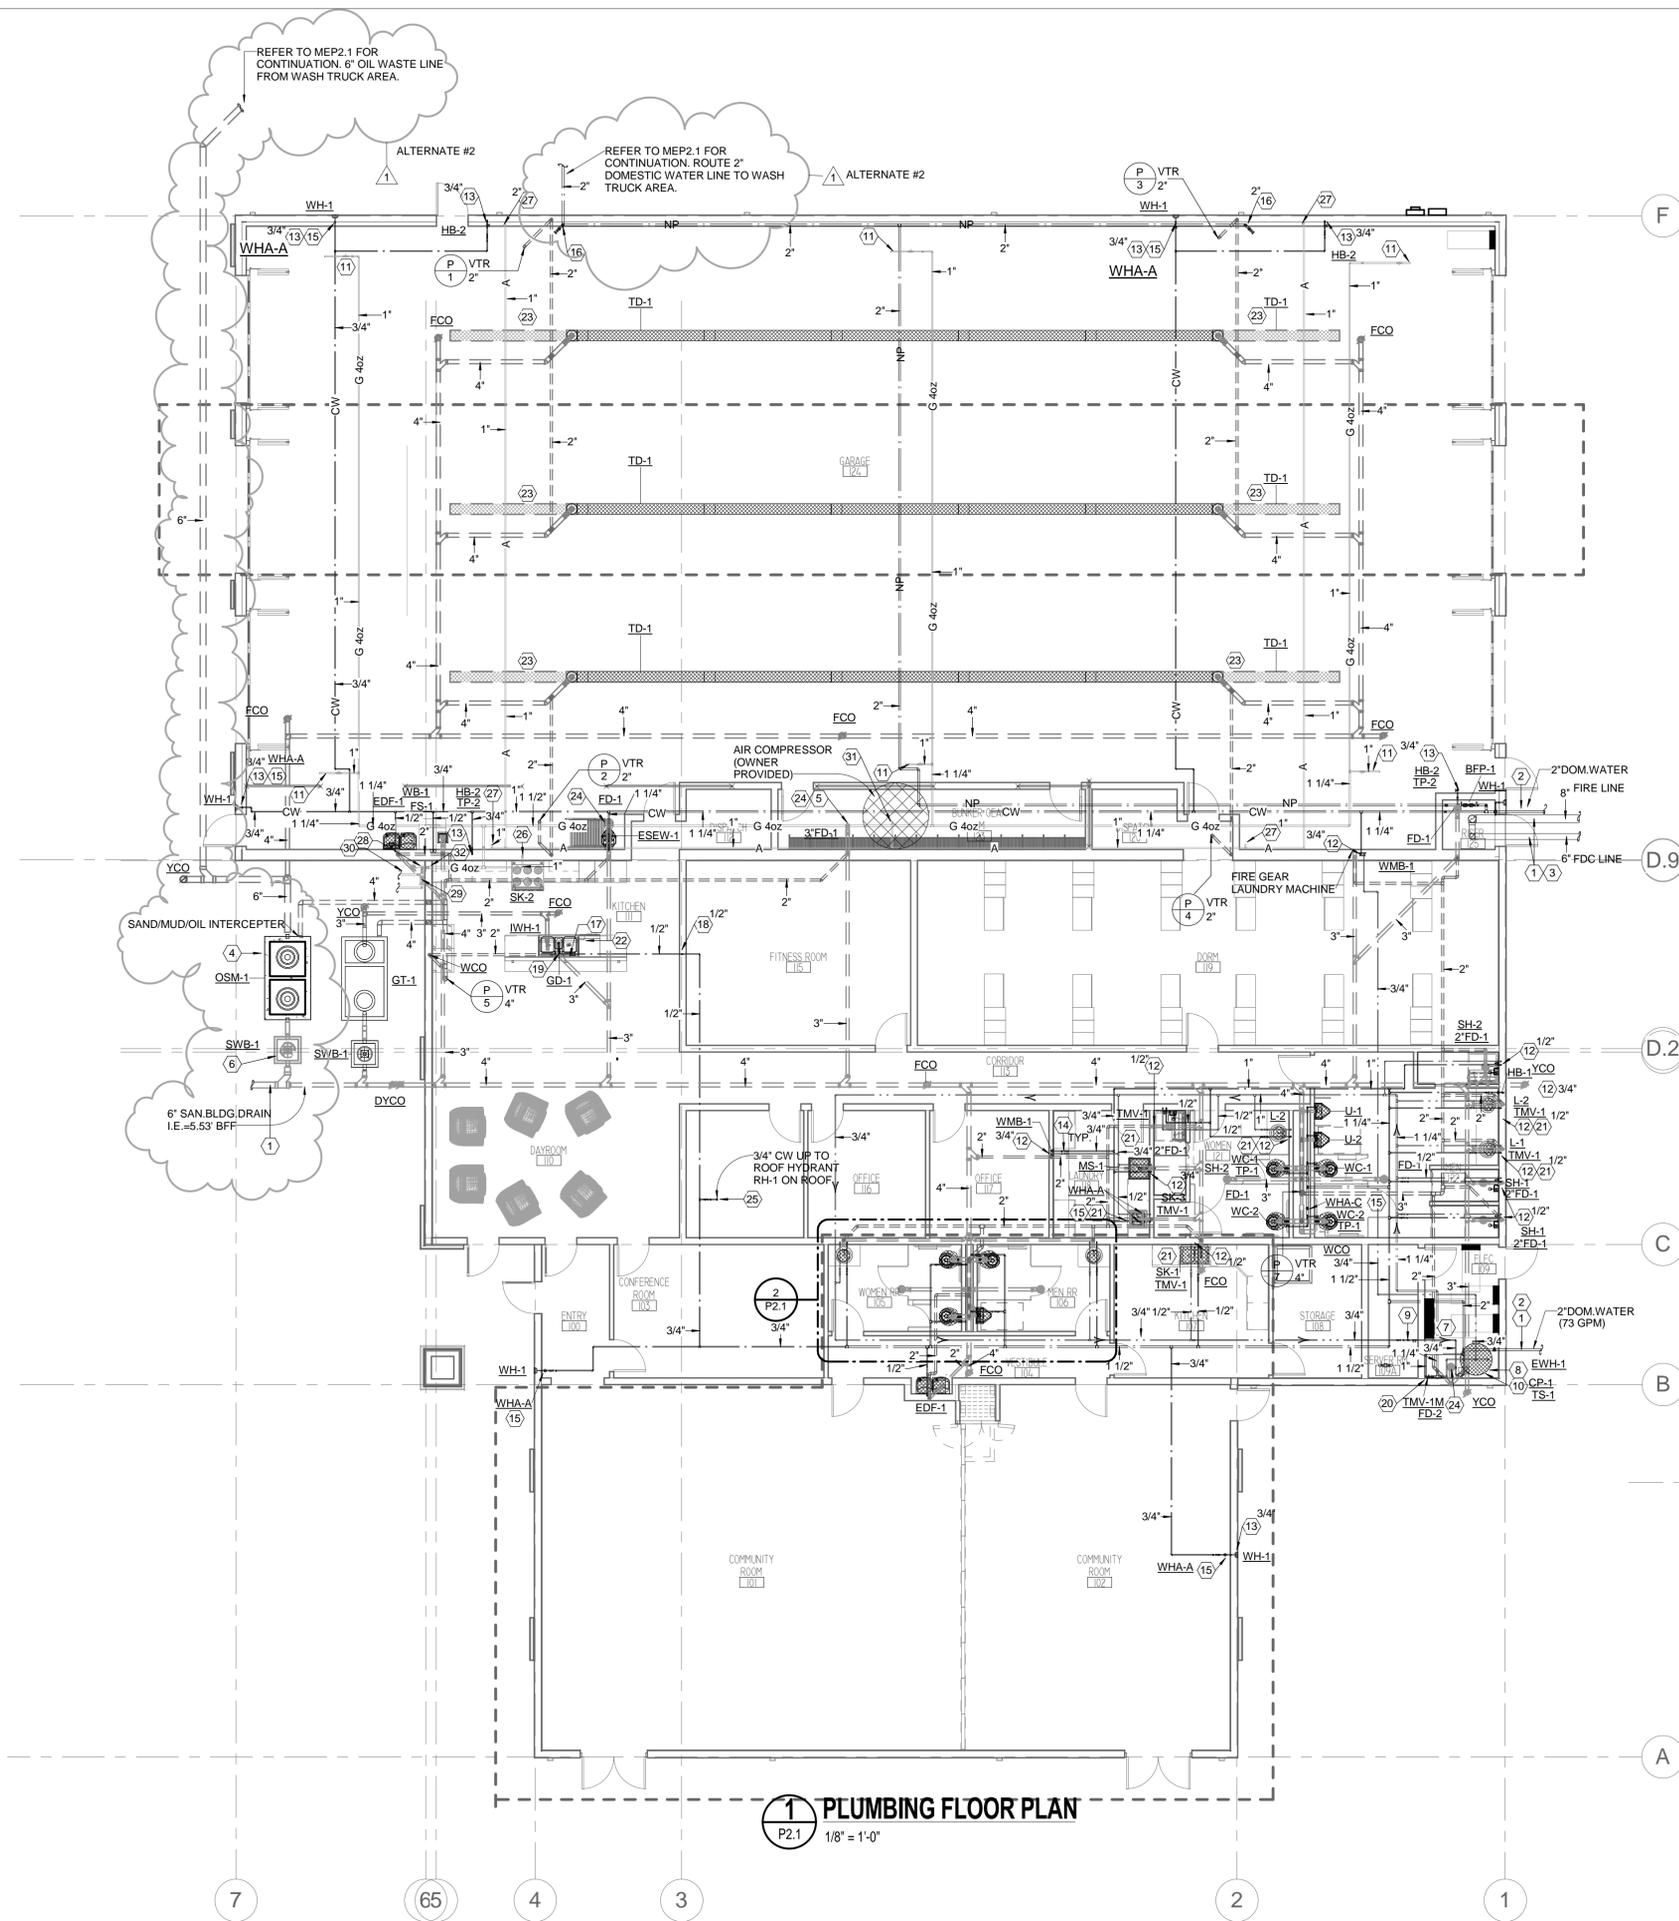


1 PLUMBING FLOOR PLAN
P2.1 1/8" = 1'-0"

- PLUMBING KEYED NOTES:**
- REFER TO CIVIL SITE UTILITY PLAN FOR CONTINUATION. CONTRACTOR TO BE RESPONSIBLE FOR COORDINATION, VERIFICATION AND CONNECTION OF ALL UTILITIES TO SITE UTILITY STUB-OUTS.
 - DOMESTI WATER ENTRY. RE: DETAIL 1/P4.2
 - FIRE SPRINKLER SYSTEM BY FIRE PROTECTION CONTRACTOR. PROVIDE FIRE SPRINKLER CONTROL/ALARM VALVE ASSEMBLY RISERS AND REMOTE FIRE DEPARTMENT CONNECTION (FDC). REFER TO CIVIL SITE PLAN FOR LOCATION OF ROADSIDE VALVE, FDC, DOUBLE CHECK VALVE BACKFLOW PREVENTER, AND POST INDICATOR VALVE. CONTRACTOR IS RESPONSIBLE FOR FINAL SIZING OF PIPES AND COMPONENTS BASED ON THEIR HYDRAULIC CALCULATIONS RE: DETAIL 2/P4.2 AND 2/P4.2.
 - PROVIDE SAND/OIL INTERCEPTOR EQUAL TO PARK MODEL NO. SOCM-P750 GALLON PRE-CAST, DIRECT BURIAL INTERCEPTOR. RE: DETAIL 1/P4.3
 - PROVIDE FLOOR DRAIN IN MEZZANINE FLOOR. ROUTE SANITARY DOWN THROUGH WALL.
 - PROVIDE SAMPLE WELL BASIN EQUAL TO PARK MODEL SWB-154, SEE DETAIL 3/P4.3.
 - COORDINATE LOCATION OF FLOOR DRAINS WITH MECHANICAL CONTRACTOR PRIOR TO SLAB CONSTRUCTION.
 - ELECTRIC WATER HEATER, REFER TO DETAIL 11/P4.2.
 - HOT WATER CIRCULATING SYSTEM BALANCING VALVE. RE: DETAIL 11/P4.2.
 - 3/4" HOT WATER RETURN DROP TO CIRCULATING PUMP (CP-1) WITH TIME SWITCH (TS-1); SEE DETAIL 19/P4.2.
 - 1" GAS (75 CFH) TO EACH HVAC EQUIPMENT. SIZE AS NOTED AND AS SHOWN ON PLAN. PROVIDE ALL FINAL CONNECTIONS AN ASSOCIATED VALVES.
 - COLD AND HOT WATER DROPS TO FIXTURE(S) OR EQUIPMENT. SIZED AS NOTED. PROVIDE WATER HAMMER ARRESTORS AS INDICATED. REFER TO PLUMBING RISER DIAGRAM FOR CONTINUATION IN WALL OR CHASE.
 - COLD WATER DROP TO FIXTURE(S) OR EQUIPMENT. SIZED AS NOTED. PROVIDE WATER HAMMER ARRESTOR AS INDICATED. REFER TO PLUMBING RISER DIAGRAM FOR CONTINUATION IN WALL OR CHASE.
 - BALL VALVE ABOVE CEILING. PROVIDE ACCESS PANEL WHERE LOCATED IN AN INACCESSIBLE CEILING. PANEL SHALL BE 12"x12" PAINTED TO MATCH CEILING.
 - WATER HAMMER ARRESTOR. PROVIDE ACCESS PANEL WHERE LOCATED IN AN INACCESSIBLE WALL/CEILING. PANEL SHALL BE 12"x12" PAINTED TO MATCH WALL/CEILING.
 - 2" CW (NON-POTABLE) DOWN ANCHORED TO WALL AND PROVIDE A 2" BALL VALVE WITH 2" THREADED FITTING FOR "QUICK FILLING" OF FIRE TRUCKS. EXACT LOCATION AND MOUNTING HEIGHT ABOVE FINISH FLOOR AS DIRECTED BY ARCHITECT/OWNER.
 - PROVIDE PER CODE ISLAND VENT AND WASTE, REFER TO DETAIL 10/P4.2.
 - 1/2" CW DOWN IN WALL/CHASE. CONTINUE ROUTING BELOW SLAB IN SLEEVE TO SK-2 AS SHOWN ON PLAN.
 - 1/2" CW UP FROM BELOW SLAB IN SLEEVE TO SK-2.
 - PROVIDE TMV-1M AND SUPPLY TEMPERED WATER MAXIMUM OF 110°F TO FIXTURES. RE: DETAIL 11/P4.2.
 - PROVIDE LAVATORY WITH TMV-1 SET AT MAXIMUM OF 105°F. INSTALL TMV BELOW FIXTURE AS HIGH AS POSSIBLE. RE: 12/P4.2.
 - CONNECT DISHWASHER WASTE DISCHARGE FULL SIZE TO DISPOSAL UNDER SINK WITH AIRGAP FITTING. RE: DETAIL 13/P4.2.
 - 4" WASTE DOWN FROM TRENCH DRAIN TD-1. PROVIDE ZURN MODEL No. Z812 FIBER REINFORCED POLYMER TRENCH DRAIN SYSTEM WITH STEEL FRAME. REFER TO P4.1 FOR SCHEDULE.
 - PROVIDE PROSET SYSTEMS INC. "TRAP GUARD" SEWER GAS EMISSION PROTECTION IN THIS FLOOR DRAIN. RE: DETAIL 14/P4.2.
 - 3/4" CW UP TO ROOF HYDRANT RH-1. ROUTE DRAIN TO NEAREST LAVATORY TAILPIECE. COORDINATE WITH STRUCTURAL PRIOR TO ROOF PENETRATIONS. RE: DETAIL 17/P4.2.
 - 1" GAS (213 CFH) PIPING DN IN WALL/CHASE IN PVC SLEEVE FOR STOVE. PROVIDE ALL FINAL CONNECTIONS, ASSOCIATED VALVE AND DIRT LEG.
 - COMPRESSED AIR OUTLET WITH REGULAR AUTOMOTIVE AIR HOSE BIBB FEMALE CONNECTOR AND UNIVERSAL TWIST LOCK CONNECTOR WITH 1/4 TURN GATE VALVE.
 - GAS PRESSURE REGULATOR, 7" W.C. PRESSURE SET TO DELIVER A DEMAND OF 663 CFH, 200 FT. DEVELOPED LENGTH. CONTACT GAS COMPANY AND COORDINATE EXACT LOCATION WITH OWNER. PENETRATE EXTERIOR WALL TO ROUTE GAS PIPING INSIDE BUILDING.
 - GAS METER ASSEMBLY BY LOCAL UTILITY COMPANY. TOTAL DEMAND AT 2,706 CFH.
 - 1-1/4" GAS LINE BELOW GRADE TO EMERGENCY GENERATOR; REFER TO SITE PLAN FOR CONTINUATION. PROVIDE SCHEDULE 40 PVC SLEEVE BELOW PAVED AREAS.
 - AIR LINE FROM AIR COMPRESSOR PROVIDED BY OWNER AND INSTALLED BY CONTRACTOR. CONTRACTOR TO PROVIDE ALL FINAL CONNECTIONS.
 - SLEEVE GAS PIPING THRU WALL. TYPICAL.

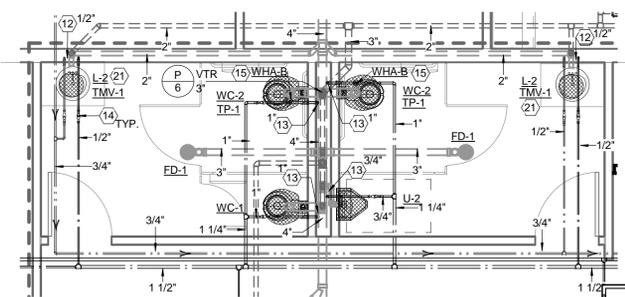

2 ENLARGED PLAN - WOMEN RR 105 & MEN RR 106
P2.1 1/4" = 1'-0"

NOTES:
DRAWING IS DIAGRAMMATIC ONLY. CONTRACTOR SHALL COORDINATE EXACT LOCATIONS OF PIPING, DEVICES AND EQUIPMENT WITH BUILDING ELEMENTS AND THE WORK OF OTHER TRADES.
ALL PIPING SUBJECT TO FREEZE IN GARAGE AREA SHALL BE INSULATED.

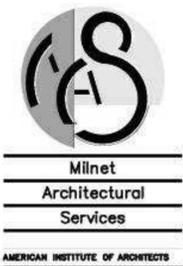

EDINBURG FIRE STATION #5
CITY OF EDINBURG
JASMAN RD & FM2812

PROJECT NUMBER 214000
DATE JANUARY 07, 2016

ADDENDUM # 01-07-16

SHEET
P2.1
OF

DBR
200 South 10th Street Suite 901
Mc Allen, Texas 78501
956.683.1640 p 956.683.1903 f
TBPE Firm Registration No. 2234

DBR Project Number 14815.000

EP	AS	DL	MG
----	----	----	----

